


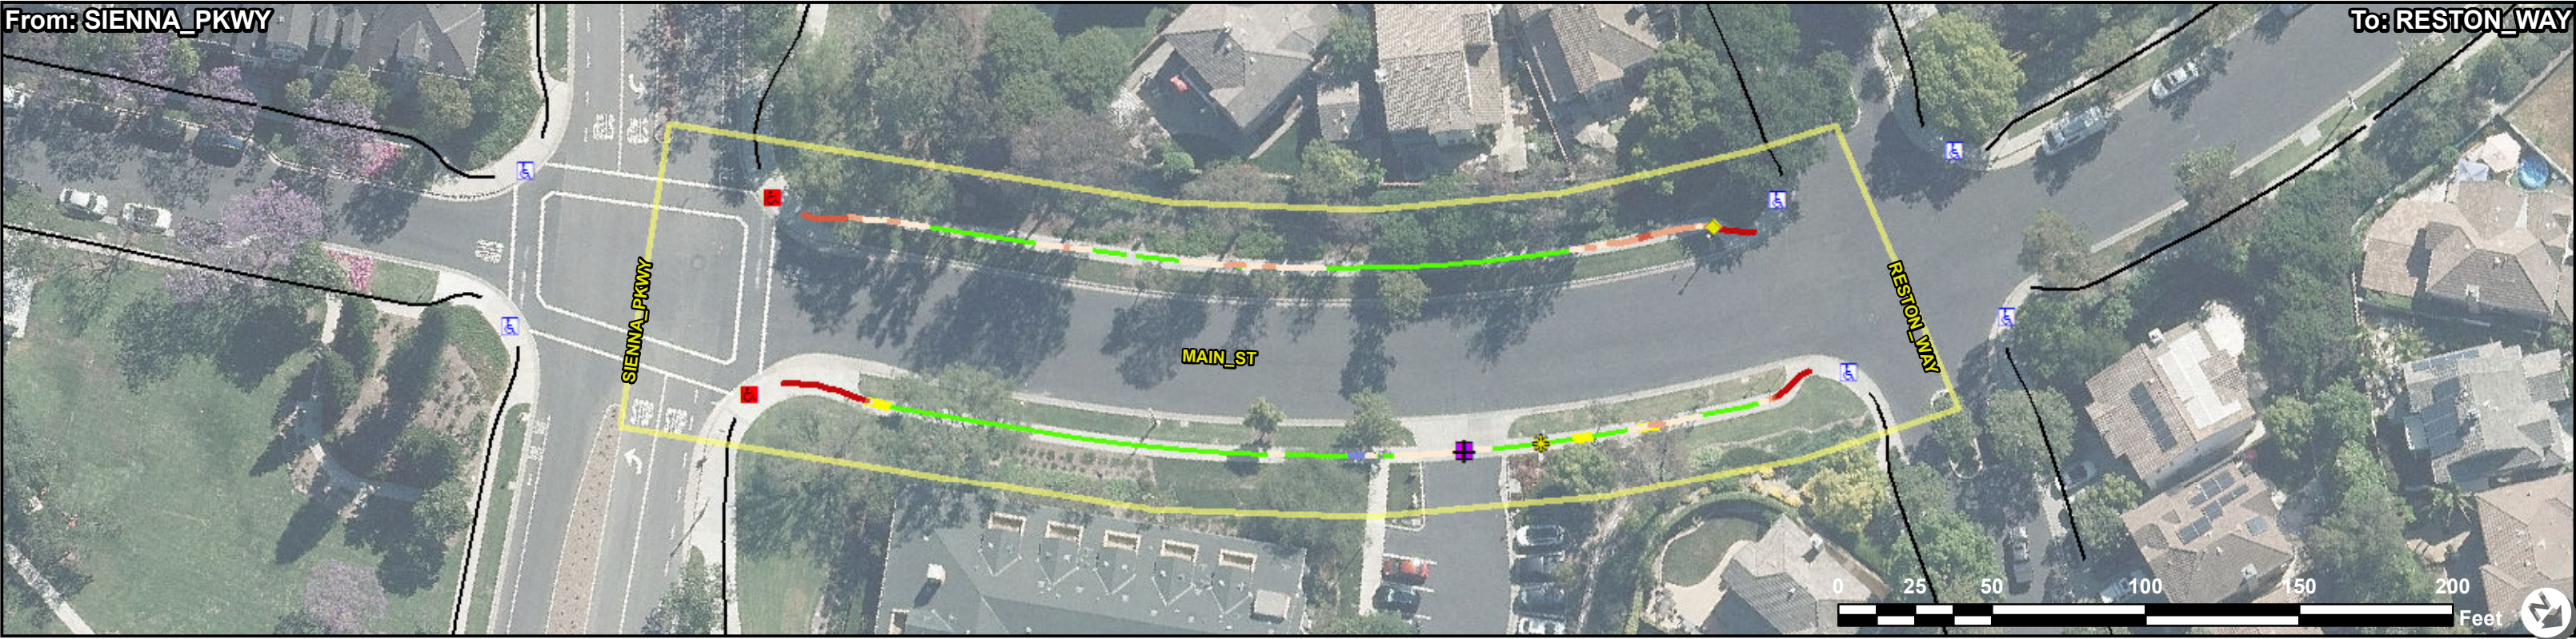

ADA Survey Summary

Item	Description	Quantity
1	Vertical Displacement <= 1"	2 EA
2	Vertical Displacement > 1"	0 EA
3	Uneven Vertical Displacement	0 EA
4	Horizontal Opening > 0.5"	0 EA
5	Poor Surface Condition	12 SY
6	Utility Obstruction	0 EA
7	Power Pole Obstruction	0 EA
8	Traffic Signal Obstruction	0 EA
9	Sign Obstruction	0 EA
10	Low Vegetative Obstruction	0 EA
11	Overhead Vegetative Obstruction	0 EA
12	Other Obstruction*	0 EA
13	Miscellaneous Obstruction	0 EA
14	Temp/Private Obstruction	0 EA
15	Commercial Driveway	28 LF
16	Residential Driveway	0 LF
17	Total Sidewalk Length Assessed	648 LF
18	Average Sidewalk Width	60 IN
19	Curb Ramps In Corridor	2 EA
20	Island Curb Cuts In Corridor	0 EA
21	Signal Push Buttons In Corridor	0 EA
22	Accessible Parking Spaces In Corridor	0 EA
23	Missing Sidewalk/Gaps in Connectivity	0 LF
24	Buried/Narrow Sidewalk	0 LF
25	Sidewalk Not Surveyed	0 LF
26	No Sidewalk Observed	0 LF
27	Corridor Severity Score	45.53

Google Street View Link

http://www.google.com/maps/@?api=1&map_action=pano&viewpoint=33.56521083,-117.6343265

Inventory Symbology

Running Slope (Aligned, Not Costed)
5.1 – 8.3%
8.4 – 10.0%
10.1 – 12.5%
12.5%+
Collection in Adjacent Corridors
Curb Ramps
Island Curb Cuts
Signal Push Buttons
Sidewalk Collection

ADA Compliance Cost Estimate **

Item	Description	Quantity	Unit	Unit Price	Item Cost
1	Vertical Displacement <= 1"	1 EA		\$150.00	\$ 150.00
2	Vertical Displacement > 1"	0 EA		\$2125.00	\$ 0.00
3	Uneven Vertical Displacement	0 EA		\$2125.00	\$ 0.00
4	Horizontal Opening > 0.5"	0 EA		\$1062.00	\$ 0.00
5	Poor Surface Condition	7 SY		\$255.50	\$ 1902.00
6	Utility Obstruction	0 EA		\$5000.00	\$ 0.00
7	Power Pole Obstruction	0 EA		\$20000.00	\$ 0.00
8	Traffic Signal Obstruction	0 EA		\$5000.00	\$ 0.00
9	Sign Obstruction	0 EA		\$2000.00	\$ 0.00
10	Low Vegetative Obstruction	0 EA		\$200.00	\$ 0.00
11	Overhead Vegetative Obstruction	0 EA		\$400.00	\$ 0.00
12	Other Obstruction*	0 EA		\$2000.00	\$ 0.00
13	Miscellaneous Obstruction	0 EA		\$2000.00	\$ 0.00
14	Commercial Driveway	28 LF		\$118.00	\$ 3329.00
15	Residential Driveway	0 LF		\$118.00	\$ 0.00
16	Running Slope Violation	0 SY		\$255.50	\$ 0.00
17	Cross Slope Violation	137 SY		\$255.50	\$ 35170.00
18	Running and Cross Slope violations	1 SY		\$255.50	\$ 354.00
19	Non-Compliant Curb Ramps and Total Cost*	2 EA		VARIES	\$ 8000.00
20	Non-Compliant Island Curb Cuts and Total Cost*	0 EA		VARIES	\$ 0.00
21	Non-Compliant Signal Push Buttons Cuts and Total Cost*	0 EA		VARIES	\$ 0.00
22	Non-Compliant Accessible Parking Spaces and Total Cost*	0 EA		VARIES	\$ 0.00
23	Missing Sidewalk/Gap in Connectivity	0 SY		\$150.00	\$ 0.00
24	Buried/Narrow Sidewalk	0 SY		\$255.50	\$ 0.00

Total: \$ \$48,907.00

Compliance Symbology

Compliant Curb Ramp
Non-Compliant Curb Ramp
Compliant Island Curb Cut
Non-Compliant Island Curb Cut
Compliant Signal
Non-Compliant Signal
Cross Slope
2.01 - 3.0%
3.01 - 4.0%
4.01 - 5.0%
5.01%+

Running Slope
(Deviated, Costed)

5.1 – 8.3%
8.4 – 10.0%
10.1 – 12.5%
12.5%+

*Note: Some items combined for display. See Unit Cost Table for specific unit costs for each type of obstruction, curb ramp, island curb cut. Missing sidewalk/gaps in connectivity reported together in compliance report and are separate in the GIS layers.

**Note: ADA pedestrian issues have been identified and quantified in the ADA Survey Summary. There are instances where multiple issues can be resolved with a single corrective measure. The ADA Compliance Cost Estimate reflects the best estimation of quantities and cost to resolve all identified ADA issues.