


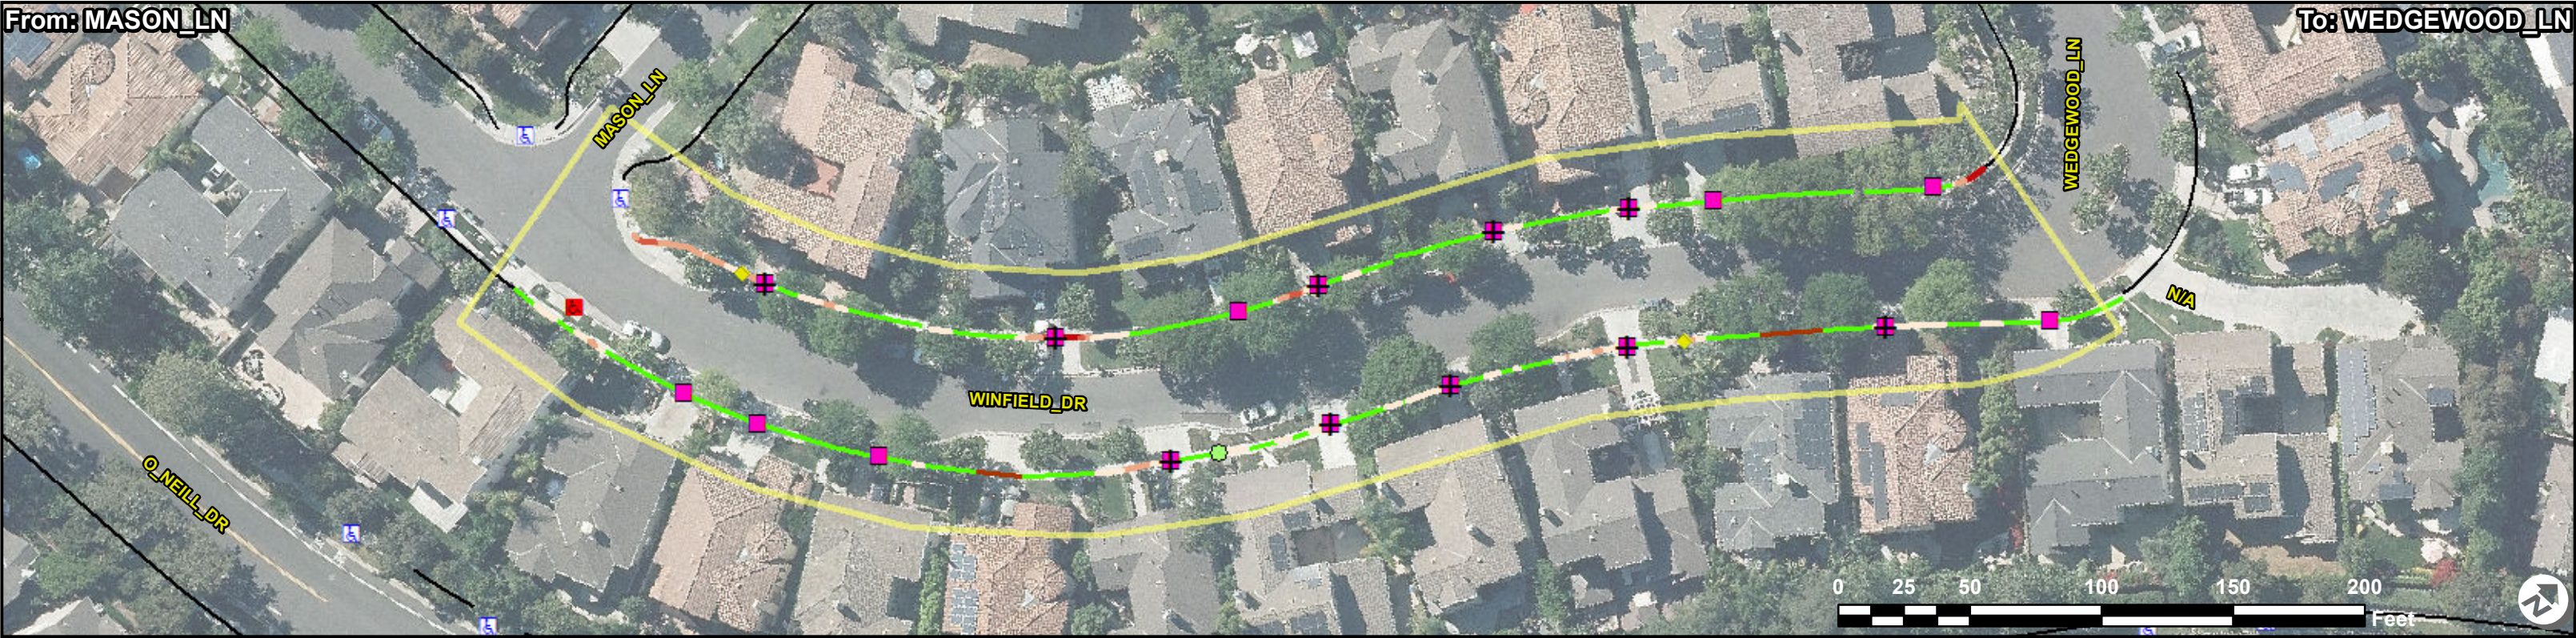

ADA Survey Summary

Item	Description	Quantity
1	Vertical Displacement <= 1"	2 EA
2	Vertical Displacement > 1"	0 EA
3	Uneven Vertical Displacement	0 EA
4	Horizontal Opening > 0.5"	0 EA
5	Poor Surface Condition	0 SY
6	Utility Obstruction	0 EA
7	Power Pole Obstruction	0 EA
8	Traffic Signal Obstruction	0 EA
9	Sign Obstruction	0 EA
10	Low Vegetative Obstruction	1 EA
11	Overhead Vegetative Obstruction	0 EA
12	Other Obstruction*	0 EA
13	Miscellaneous Obstruction	0 EA
14	Temp/Private Obstruction	0 EA
15	Commercial Driveway	0 LF
16	Residential Driveway	259 LF
17	Total Sidewalk Length Assessed	1113 LF
18	Average Sidewalk Width	48 IN
19	Curb Ramps In Corridor	1 EA
20	Island Curb Cuts In Corridor	0 EA
21	Signal Push Buttons In Corridor	0 EA
22	Accessible Parking Spaces In Corridor	0 EA
23	Missing Sidewalk/Gaps in Connectivity	0 LF
24	Buried/Narrow Sidewalk	0 LF
25	Sidewalk Not Surveyed	41 LF
26	No Sidewalk Observed	0 LF
27	Corridor Severity Score	105.28

Google Street View Link

http://www.google.com/maps/@?api=1&map_action=pano&viewpoint=33.56984132,-117.64098073

ADA Compliance Cost Estimate **

Item	Description	Quantity	Unit	Unit Price	Item Cost
1	Vertical Displacement <= 1"	0 EA	\$150.00	\$	0.00
2	Vertical Displacement > 1"	0 EA	\$2125.00	\$	0.00
3	Uneven Vertical Displacement	0 EA	\$2125.00	\$	0.00
4	Horizontal Opening > 0.5"	0 EA	\$1062.00	\$	0.00
5	Poor Surface Condition	0 SY	\$255.50	\$	0.00
6	Utility Obstruction	0 EA	\$5000.00	\$	0.00
7	Power Pole Obstruction	0 EA	\$20000.00	\$	0.00
8	Traffic Signal Obstruction	0 EA	\$5000.00	\$	0.00
9	Sign Obstruction	0 EA	\$2000.00	\$	0.00
10	Low Vegetative Obstruction	1 EA	\$200.00	\$	200.00
11	Overhead Vegetative Obstruction	0 EA	\$400.00	\$	0.00
12	Other Obstruction*	0 EA	\$2000.00	\$	0.00
13	Miscellaneous Obstruction	0 EA	\$2000.00	\$	0.00
14	Commercial Driveway	0 LF	\$118.00	\$	0.00
15	Residential Driveway	154 LF	\$118.00	\$	18248.00
16	Running Slope Violation	0 SY	\$255.50	\$	0.00
17	Cross Slope Violation	119 SY	\$255.50	\$	30607.00
18	Running and Cross Slope violations	0 SY	\$255.50	\$	0.00
19	Non-Compliant Curb Ramps and Total Cost*	1 EA	VARIES	\$	3080.00
20	Non-Compliant Island Curb Cuts and Total Cost*	0 EA	VARIES	\$	0.00
21	Non-Compliant Signal Push Buttons Cuts and Total Cost*	0 EA	VARIES	\$	0.00
22	Non-Compliant Accessible Parking Spaces and Total Cost*	0 EA	VARIES	\$	0.00
23	Missing Sidewalk/Gap in Connectivity	0 SY	\$150.00	\$	0.00
24	Buried/Narrow Sidewalk	0 SY	\$255.50	\$	0.00
Total:				\$	\$52,136.00

Compliance Symbology

	Compliant Curb Ramp
	Non-Compliant Curb Ramp
	Compliant Island Curb Cut
	Non-Compliant Island Curb Cut
	Compliant Signal
	Non-Compliant Signal

Cross Slope

	2.01 - 3.0%
	3.01 - 4.0%
	4.01 - 5.0%
	5.01%+

Running Slope

(Deviated, Costed)

	5.1 - 8.3%
	8.4 - 10.0%
	10.1 - 12.5%
	12.5%+

Note: Some items combined for display. See Unit Cost Table for specific unit costs for each type of obstruction, curb ramp, island curb cut. Missing sidewalk/gaps in connectivity reported together in compliance report and are separate in the GIS layers.

**Note: ADA pedestrian issues have been identified and quantified in the ADA Survey Summary. There are instances where multiple issues can be resolved with a single corrective measure. The ADA Compliance Cost Estimate reflects the best estimation of quantities and cost to resolve all identified ADA issues.