




Access Compliance Report Public Rights-of-Way (Curb Ramps)



Main Street: GILBERT_ST Cross Street: KATELLA_AVE Location: NE

ADA ID: RPAT210916103336 Ramp Type: Type 1 - Perpendicular Diagonal Initial Pass/Fail: Pass Overall Compliance: No Severity Score: 0

Codes/Mitigation Info/Possible Solution Field Measurements/Component Compliance

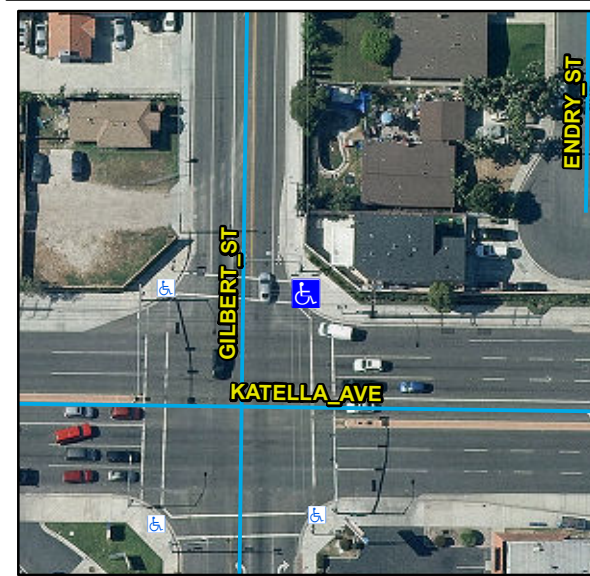

Possible Solutions:
Remove & Replace Landing.

Surveyor Notes:
N/A

OC Std/PROW:
R304.2.1, STD 1115

Total Cost: \$ 531

Parcel ID Number **127-583-11**
Ramp Island Or Median **None**
Ramp Orientation **Diag**
Google Street View Link:
http://www.google.com/maps/@?api=1&map_action=pano&viewpoint=33.80325929,-117.96746143

Street 1 Name **GILBERT_ST**
Stop Condition-Street 1 **Signal**
Street 2 Name **KATELLA_AVE**
Stop Condition-Street 2 **Signal**

Obstruction and Utility Measurement/Component Compliance

Compliance	Description	Data	Compliance	Description	Data
Yes	Obstructions Present?	No	N/A	Utilities Present?	No
	Obstruction Types	N/A		Utility Types	
	Obstruction Dimensions	N/A			N/A

Compliance	Description	Data	Compliance	Description	Data
N/A	Ramp Length (in)	128	N/A	Flare Type LT	
Yes	Ramp Width (in)	49			Sloped
Yes	Ramp Run Slope (%)	6.2	N/A	Flare Slope LT (%)	5.2
Yes	Ramp Cross Slope (%)	0.7	N/A	Flare Traversable LT	No
N/A	Landing Present	Yes	N/A	Flare Type RT	
N/A	Landing Length (in)	48			Sloped
Yes	Landing Width (in)	49	N/A	Flare Slope RT (%)	8.2
Yes	Landing Run Slope (%)	1	N/A	Flare Traversable RT	No
Yes	Landing Cross Slope (%)	0	Yes	DWS Provided	Yes
N/A	Landing Movement Obstructed?	Yes	Yes	DWS Contrast	Yes
	Landing Movement Type	Bushes	Yes	DWS Length (in)	36
N/A	Landing Shared	No	Yes	DWS Full Width	Yes
Yes	Clear Space	Yes	Yes	DWS Offset Left (in)	0
Yes	Clear Space To Crosswalk (in)	48	Yes	DWS Offset Right (in)	N/A
N/A	Marked Crosswalk 1	Yes	N/A	Marked Crosswalk 2	Yes
	Crossing 1 Direction	W		Crossing 2 Direction	S
	Marked Crosswalk 1 Width (in)	120		Marked Crosswalk 2 Width (in)	120
Yes	Ramp Inside Crosswalk 1	Yes	Yes	Ramp Inside Crosswalk 2	Yes
	Crossing 1 Slope (%)	3.3		Crossing 2 Slope (%)	3.3
	Crossing 1 Cross Slope (%)	0.9		Crossing 2 Cross Slope (%)	1.4
Yes	Gutter Ponding	No	Yes	Curb Slope	3.5
Yes	Gutter Lip Height (in)	0		Road Run Slope (%)	4.7
Yes	Gutter Run Slope (%)	2.7		Road Cross Slope (%)	0.7
Yes	Gutter Cross Slope (%)	1.2			
Yes	Overall Surface Condition: Acceptable		Yes	Perp Joint Present	Yes
	Cross Gutter Present?	No		Spandrel Present?	No
	Replace Cross Gutter?	N/A		Replace Spandrel?	N/A

