




Access Compliance Report Public Rights-of-Way (Curb Ramps)

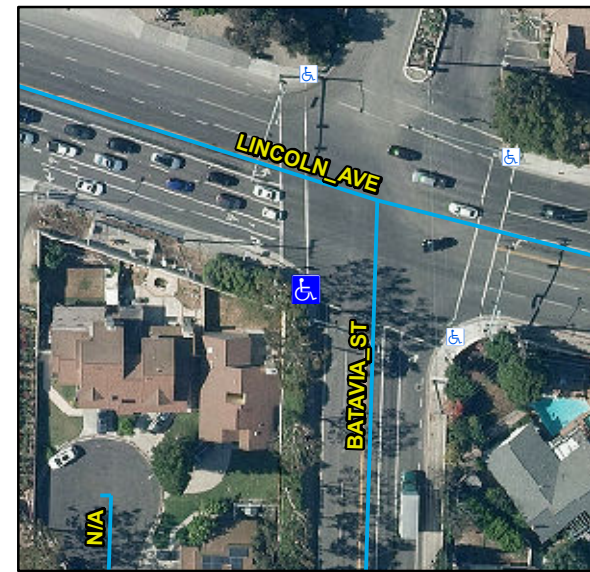

Main Street: BATAVIA_ST		Cross Street: LINCOLN_AVE		Location:	SW
ADA ID: RPAT210924093835	Ramp Type: Type 4 - Parallel	Initial Pass/Fail: Pass	Overall Compliance: Yes	Severity Score:	0
Codes/Mitigation Info/Possible Solution			Field Measurements/Component Compliance		



Possible Solutions:

N/A

Surveyor Notes:

N/A

OC Std/PROW:

N/A

Total Cost:

\$ 0

Parcel ID Number 374-731-85
Ramp Island Or Median None
Ramp Orientation Diag
Google Street View Link:

Street 1 Name BATAVIA_ST
Stop Condition-Street 1 Signal
Street 2 Name LINCOLN_AVE
Stop Condition-Street 2 Signal

http://www.google.com/maps/@?api=1&map_action=pano&viewpoint=33.83491732,-117.86188397

Obstruction and Utility Measurement/Component Compliance

Compliance	Description	Data	Compliance	Description	Data
Yes	Obstructions Present?	No	N/A	Utilities Present?	No
	Obstruction Types	N/A		Utility Types	
	Obstruction Dimensions	N/A			N/A

Compliance	Description	Data	Compliance	Description	Data
N/A	Ramp Length LT (in)	94	N/A	Ramp Length RT (in)	86
Yes	Ramp Width LT (in)	67	Yes	Ramp Width RT (in)	65
Yes	Ramp Run Slope LT (%)	1.2	Yes	Ramp Run Slope RT (%)	8.2
Yes	Ramp Cross Slope LT (%)	1.3	Yes	Ramp Cross Slope RT (%)	1.6
N/A	Landing Present	Yes	Yes	DWS Provided	Yes
N/A	Landing Length (in)	63	Yes	DWS Contrast	Yes
Yes	Landing Width (in)	48	Yes	DWS Length (in)	36
Yes	Landing Run Slope (%)	0.8	Yes	DWS Full Width	Yes
Yes	Landing Cross Slope (%)	2		DWS Offset Type	Single
N/A	Landing Movement Obstructed?	No	Yes	DWS Offset Left (in)	0
	Landing Movement Type	Curb	Yes	DWS Offset Right (in)	N/A
N/A	Landing Shared	No			
Yes	Clear Space	Yes			
Yes	Clear Space To Crosswalk (in)	48			
N/A	Marked Crosswalk 1	Yes	N/A	Marked Crosswalk 2	Yes
	Crossing 1 Direction	E		Crossing 2 Direction	N
	Marked Crosswalk 1 Width (in)	120		Marked Crosswalk 2 Width (in)	120
Yes	Ramp Inside Crosswalk 1	Yes	Yes	Ramp Inside Crosswalk 2	Yes
	Crossing 1 Slope (%)	2.6		Crossing 2 Slope (%)	7.1
	Crossing 1 Cross Slope (%)	9.6		Crossing 2 Cross Slope (%)	2.3
Yes	Gutter Ponding	No	Yes	Curb Slope	4.9
Yes	Gutter Lip Height (in)	0		Road Run Slope (%)	2.6
Yes	Gutter Run Slope (%)	3.3		Road Cross Slope (%)	3.1
Yes	Gutter Cross Slope (%)	2.4	Yes	Perpendicular Joint Present	Yes
Yes	Overall Surface Condition	Acceptable			
	Cross Gutter Present?	No		Spandrel Present?	No
	Replace Cross Gutter?	N/A		Replace Spandrel?	N/A

