




Access Compliance Report Public Rights-of-Way (Curb Ramps)

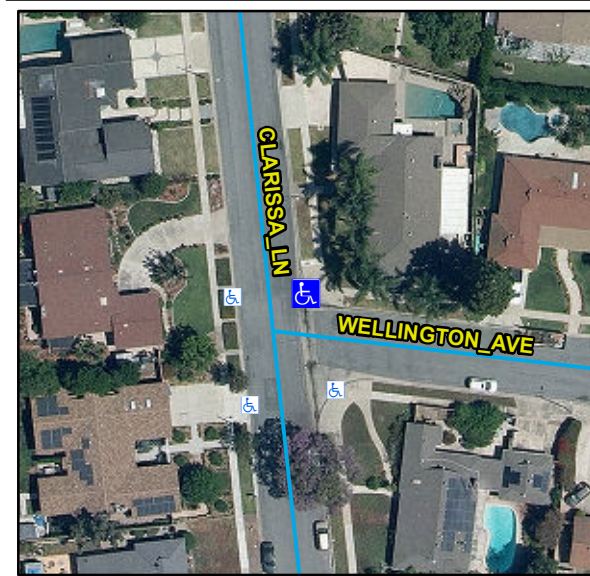

Main Street: CLARISSA_LN		Cross Street: WELLINGTON_AVE		Location:	NE
ADA ID: RPAT211006091125	Ramp Type: No Ramp	Initial Pass/Fail: N/A	Overall Compliance: No	Severity Score:	100
Codes/Mitigation Info/Possible Solution			Field Measurements/Component Compliance		



Possible Solutions:

Provide Curb Ramp

Surveyor Notes:

N/A

OC Std/PROW:

STD 1115

Total Cost: \$ 3080

Parcel ID Number	401-121-04	Street 1 Name	CLARISSA_LN
Ramp Island Or Median	N/A	Stop Condition-Street 1	N/A
Ramp Orientation	N/A	Street 2 Name	WELLINGTON_AVE
Google Street View Link:		Stop Condition-Street 2	N/A

http://www.google.com/maps/@?api=1&map_action=pano&viewpoint=33.7563461,-117.81292552

Compliance	Description	Data	Compliance	Description	Data

