




Access Compliance Report Public Rights-of-Way (Curb Ramps)

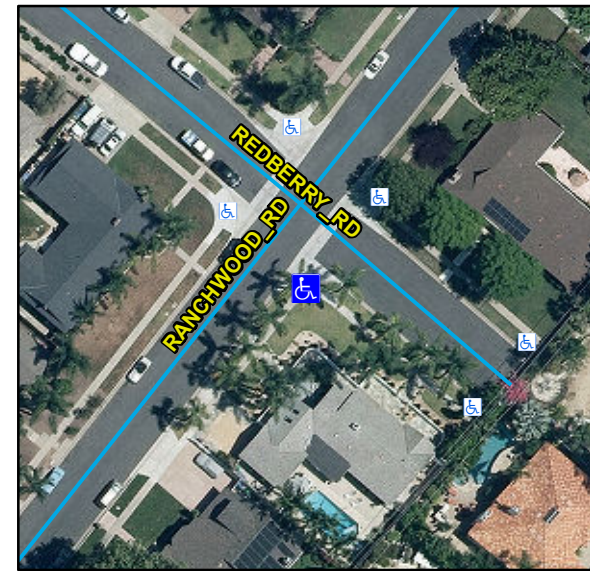

Main Street: REDBERRY_RD		Cross Street: RANCHWOOD_RD		Location:	SE
ADA ID: RPAT211013144355	Ramp Type: Type 3 - Combination 1	Initial Pass/Fail: Pass	Overall Compliance: No	Severity Score:	0
Codes/Mitigation Info/Possible Solution			Field Measurements/Component Compliance		



Possible Solutions:

Remove & Replace Curb Slope. Remove & Replace Sidewalk.

Surveyor Notes:

N/A

OC Std/PROW:

R304.2.2, R304.5.3, STD 1115

Total Cost: \$ 1008

Parcel ID Number	104-443-05	Street 1 Name	REDBERRY_RD
Ramp Island Or Median	None	Stop Condition-Street 1	NoControl
Ramp Orientation	Diag	Street 2 Name	RANCHWOOD_RD
Google Street View Link:		Stop Condition-Street 2	NoControl

http://www.google.com/maps/@?api=1&map_action=pano&viewpoint=33.74713123,-117.78821011

Obstruction and Utility Measurement/Component Compliance

Compliance	Description	Data	Compliance	Description	Data
Yes	Obstructions Present?	No	N/A	Utilities Present?	No
	Obstruction Types	N/A		Utility Types	
	Obstruction Dimensions	N/A			N/A



Compliance	Description	Data	Compliance	Description	Data
N/A	Ramp Length LT (in)	88	N/A	Ramp Length RT (in)	33
Yes	Ramp Width LT (in)	52	Yes	Ramp Width RT (in)	55
Yes	Ramp Run Slope LT (%)	7.6	Yes	Ramp Run Slope RT (%)	0.9
Yes	Ramp Cross Slope LT (%)	1	No	Ramp Cross Slope RT (%)	2.4
N/A	Ramp Length (in)	71	N/A	Flare Type LT	
Yes	Ramp Width (in)	48			Sloped
Yes	Ramp Run Slope (%)	7.4	N/A	Flare Slope LT (%)	7.7
Yes	Ramp Cross Slope (%)	2	N/A	Flare Traversable LT	No
N/A	Landing Present	Yes	N/A	Flare Type RT	
Yes	Landing Length (in)	49			Sloped
Yes	Landing Width (in)	48	N/A	Flare Slope RT (%)	5.4
Yes	Landing Run Slope (%)	1.8	N/A	Flare Traversable RT	No
Yes	Landing Cross Slope (%)	2.6	Yes	DWS Provided	Yes
N/A	Landing Movement Obstructed?	No	Yes	DWS Contrast	Yes
	Landing Movement Type	N/A	Yes	DWS Length (in)	36
N/A	Landing Shared	No	Yes	DWS Full Width	Yes
N/A	Clear Space	Yes		DWS Offset Type	Single
N/A	Clear Space To Crosswalk (in)	48	Yes	DWS Offset Left (in)	1
			Yes	DWS Offset Right (in)	N/A
Yes	Perp Joint Present	Yes			
	Parallel Ramp Side	N/A			
N/A	Marked Crosswalk 1	No	N/A	Marked Crosswalk 2	No
	Crossing 1 Direction	NW		Crossing 2 Direction	NE
	Marked Crosswalk 1 Width (in)	N/A		Marked Crosswalk 2 Width (in)	N/A
N/A	Ramp Inside Crosswalk 1	N/A	Yes	Ramp Inside Crosswalk 2	N/A
	Crossing 1 Slope (%)	5.6		Crossing 2 Slope (%)	5.7
	Crossing 1 Cross Slope (%)	3.6		Crossing 2 Cross Slope (%)	1.2
Yes	Gutter Ponding	No	No	Curb Slope	12.1
Yes	Gutter Lip Height (in)	0		Road Run Slope (%)	4.7
Yes	Gutter Run Slope (%)	1.5		Road Cross Slope (%)	3.1
Yes	Gutter Cross Slope (%)	3			
Yes	Overall Surface Condition:	Acceptable			
	Cross Gutter Present?	Yes		Spandrel Present?	Yes
	Replace Cross Gutter?	No		Replace Spandrel?	No