




Access Compliance Report Public Rights-of-Way (Curb Ramps)

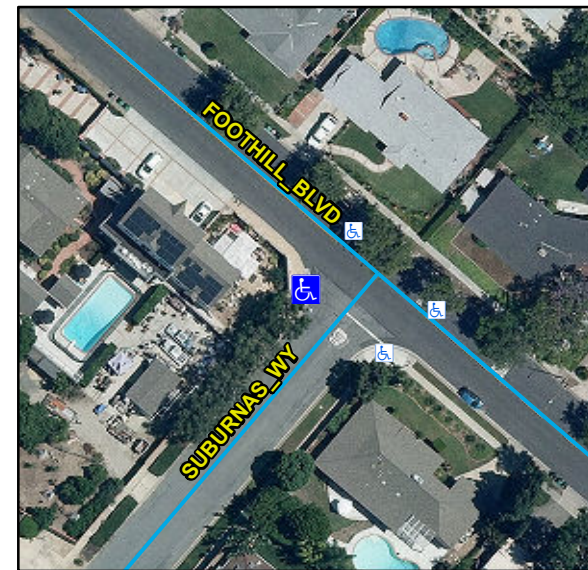

Main Street: SUBURNAS_WY		Cross Street: FOOTHILL_BLVD		Location:	W
ADA ID: RPAT211018085114	Ramp Type: Type 6 - Directional 1	Initial Pass/Fail: Pass	Overall Compliance: No	Severity Score:	9
Codes/Mitigation Info/Possible Solution			Field Measurements/Component Compliance		



Possible Solutions:

Remove & Replace Curb Ramp With Two New Directional Ramps or Equivalent. Remove & Replace Gutter.

Surveyor Notes:

N/A

OC Std/PROW:

R304.2.2, R304.2.1, R304.5.3, R304.5.4, STD 1115


Total Cost: \$ 3332

Parcel ID Number	502-221-17	Street 1 Name	SUBURNAS_WY
Ramp Island Or Median	None	Stop Condition-Street 1	StopSign
Ramp Orientation	Diag	Street 2 Name	FOOTHILL_BLVD
Google Street View Link:		Stop Condition-Street 2	NoControl

http://www.google.com/maps/@?api=1&map_action=pano&viewpoint=33.76617178,-117.79446169

Obstruction and Utility Measurement/Component Compliance

Compliance	Description	Data	Compliance	Description	Data
Yes	Obstructions Present?	No	N/A	Utilities Present?	No
	Obstruction Types	N/A		Utility Types	
	Obstruction Dimensions	N/A			N/A

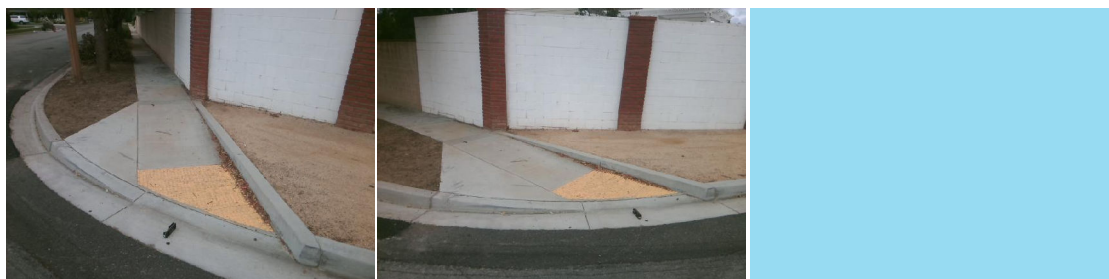

Compliance	Description	Data	Compliance	Description	Data
N/A	Ramp Length (in)	158	N/A	Flare Type LT	
Yes	Ramp Width (in)	48			Sloped
Yes	Ramp Run Slope (%)	0.4	N/A	Flare Slope LT (%)	2.5
Yes	Ramp Cross Slope (%)	0.3	N/A	Flare Traversable LT	No
Yes	Grade Break	Yes	Yes	Flare Type RT	
Yes	Grade Break Slope (%)	1.6			Curbed2
No	Grade Break Cross Slope (%)	3.3	N/A	Flare Slope RT (%)	N/A
	Addl Para Ramp Left?	No	N/A	Flare Traversable RT	N/A
	Addl Para Ramp Right?	No	Yes	DWS Provided	Yes
N/A	Landing Present	Yes	Yes	DWS Contrast	Yes
Yes	Landing Length (in)	64	Yes	DWS Length (in)	48
No	Landing Width (in)	47	Yes	DWS Full Width	Yes
Yes	Landing Run Slope (%)	0.8		DWS Offset Type	Single
Yes	Landing Cross Slope (%)	1.4	Yes	DWS Left Offset (in)	1
N/A	Landing Movement Obstructed?	No	N/A	DWS Right Offset (in)	2
	Landing Movement Type	N/A			
N/A	Landing Shared	No			
N/A	Marked Crosswalk 1	No	N/A	Clear Space	Yes
	Crossing 1 Direction	SE	N/A	Clear Space To Crosswalk (in)	48
	Marked Crosswalk 1 Width (in)	N/A			
N/A	Ramp Inside Crosswalk 1	N/A			
	Crossing 1 Slope (%)	7.1			
	Crossing 1 Cross Slope (%)	4.7			
Yes	Gutter Ponding	No	No	Curb Slope	8.6
Yes	Gutter Lip Height (in)	0		Road Run Slope (%)	1.8
No	Gutter Run Slope (%)	5.2		Road Cross Slope (%)	8.2
No	Gutter Cross Slope (%)	3.8		Parallel Ramp Side	N/A
Yes	Overall Surface Condition	Acceptable	Yes	Perp Joint Present	Yes
	Cross Gutter Present?	No		Spandrel Present?	No
	Replace Cross Gutter?	N/A		Replace Spandrel?	N/A