



# Access Compliance Report Public Rights-of-Way (Curb Ramps)




Main Street: N/A Cross Street: PROSPECT\_ST Location: SE

ADA ID: RPAT211022105723 Ramp Type: Type 6 - Directional 1 Initial Pass/Fail: Pass Overall Compliance: No Severity Score: 4

## Codes/Mitigation Info/Possible Solution

## Field Measurements/Component Compliance

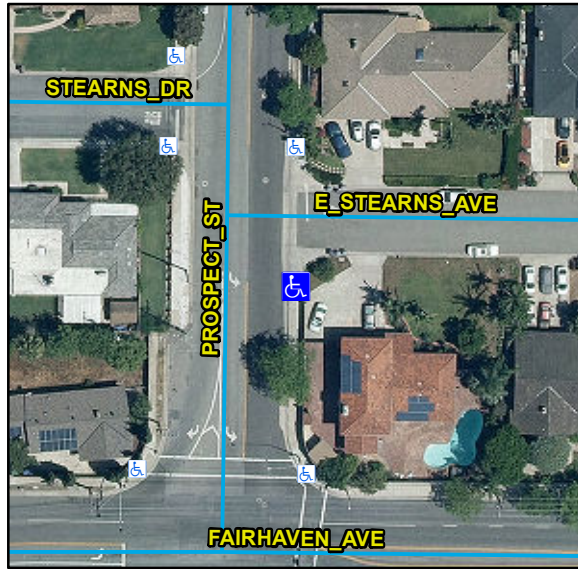

### Possible Solutions:

Remove & Replace Entire Ramp. Remove & Replace Gutter.

### Surveyor Notes:

N/A

### OC Std/PROW:

R304.2.1, R304.5.3, R304.2.3, STD 1115

Total Cost: \$ 3332

Parcel ID Number 094-354-01  
Ramp Island Or Median None  
Ramp Orientation NonDiag  
Google Street View Link:

[http://www.google.com/maps/@?api=1&map\\_action=pano&viewpoint=33.7738687,-117.81825591](http://www.google.com/maps/@?api=1&map_action=pano&viewpoint=33.7738687,-117.81825591)

Street 1 Name N/A  
Stop Condition-Street 1 StopSign  
Street 2 Name PROSPECT\_ST  
Stop Condition-Street 2 N/A

## Obstruction and Utility Measurement/Component Compliance

| Compliance | Description            | Data | Compliance | Description        | Data |
|------------|------------------------|------|------------|--------------------|------|
| Yes        | Obstructions Present?  | No   | N/A        | Utilities Present? | No   |
|            | Obstruction Types      | N/A  |            | Utility Types      |      |
|            | Obstruction Dimensions | N/A  |            |                    | N/A  |

| Compliance | Description                   | Data       | Compliance | Description                   | Data     |
|------------|-------------------------------|------------|------------|-------------------------------|----------|
| N/A        | Ramp Length (in)              | 103        | Yes        | Flare Type LT                 |          |
| Yes        | Ramp Width (in)               | 51         |            |                               | Curbed2  |
| Yes        | Ramp Run Slope (%)            | 3.5        | N/A        | Flare Slope LT (%)            | N/A      |
| Yes        | Ramp Cross Slope (%)          | 1.5        | N/A        | Flare Traversable LT          | N/A      |
| Yes        | Grade Break                   | Yes        | No         | Flare Type RT                 |          |
| Yes        | Grade Break Slope (%)         | 1.5        |            |                               | Curbed1  |
| Yes        | Grade Break Cross Slope (%)   | 1          | N/A        | Flare Slope RT (%)            | N/A      |
|            | Addl Para Ramp Left?          | No         | N/A        | Flare Traversable RT          | N/A      |
|            | Addl Para Ramp Right?         | No         | Yes        | DWS Provided                  | Yes      |
| N/A        | Landing Present               | Yes        | Yes        | DWS Contrast                  | Yes      |
| No         | Landing Length (in)           | 42         | Yes        | DWS Length (in)               | 36       |
| Yes        | Landing Width (in)            | 57         | Yes        | DWS Full Width                | Yes      |
| Yes        | Landing Run Slope (%)         | 0.8        |            | DWS Offset Type               | Multiple |
| No         | Landing Cross Slope (%)       | 2.1        | Yes        | DWS Left Offset (in)          | 60       |
| N/A        | Landing Movement Obstructed?  | No         | Yes        | DWS Right Offset (in)         | 0        |
|            | Landing Movement Type         | N/A        |            |                               |          |
| N/A        | Landing Shared                | No         |            |                               |          |
| N/A        | Marked Crosswalk 1            | No         | N/A        | Clear Space                   | N/A      |
|            | Crossing 1 Direction          | N          | N/A        | Clear Space To Crosswalk (in) | N/A      |
|            | Marked Crosswalk 1 Width (in) | N/A        |            |                               |          |
| N/A        | Ramp Inside Crosswalk 1       | N/A        |            |                               |          |
|            | Crossing 1 Slope (%)          | 0.5        |            |                               |          |
|            | Crossing 1 Cross Slope (%)    | 6.6        |            |                               |          |
| Yes        | Gutter Ponding                | No         | Yes        | Curb Slope                    | 3.3      |
| Yes        | Gutter Lip Height (in)        | 0          |            | Road Run Slope (%)            | N/A      |
| Yes        | Gutter Run Slope (%)          | 1.7        |            | Road Cross Slope (%)          | N/A      |
| No         | Gutter Cross Slope (%)        | 5          |            | Parallel Ramp Side            | Left     |
| Yes        | Overall Surface Condition     | Acceptable | Yes        | Perp Joint Present            | Yes      |
|            | Cross Gutter Present?         | Yes        |            | Spandrel Present?             | Yes      |
|            | Replace Cross Gutter?         | No         |            | Replace Spandrel?             | No       |

