




Access Compliance Report Public Rights-of-Way (Curb Ramps)

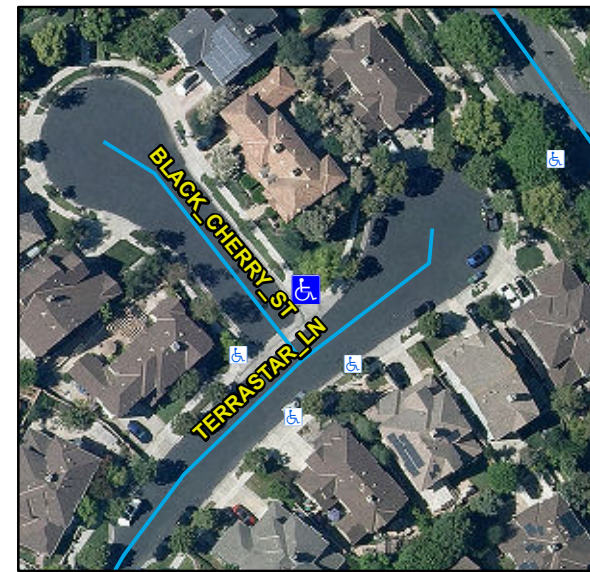

Main Street: BLACK_CHERRY_ST		Cross Street: TERRASTAR_LN		Location:	NE
ADA ID: RPAT211101093638	Ramp Type: Type 4 - Parallel	Initial Pass/Fail: Pass	Overall Compliance: No	Severity Score:	12
Codes/Mitigation Info/Possible Solution			Field Measurements/Component Compliance		



Possible Solutions:

Remove & Replace Curb Ramp With Two New Directional Ramps or Equivalent. Remove & Replace Gutter.

Surveyor Notes:

N/A

OC Std/PROW:

R204.3, R304.5.3, R304.2.2-Perp, R304.3.2-Para, R305, STD 1115


Total Cost: \$ 4252

Parcel ID Number	759-452-17	Street 1 Name	BLACK_CHERRY_ST
Ramp Island Or Median	None	Stop Condition-Street 1	NoControl
Ramp Orientation	Diag	Street 2 Name	TERRASTAR_LN
Google Street View Link:		Stop Condition-Street 2	NoControl

http://www.google.com/maps/@?api=1&map_action=pano&viewpoint=33.55796852,-117.634217

Obstruction and Utility Measurement/Component Compliance

Compliance	Description	Data	Compliance	Description	Data
Yes	Obstructions Present?	No	N/A	Utilities Present?	No
	Obstruction Types	N/A		Utility Types	
	Obstruction Dimensions	N/A			N/A

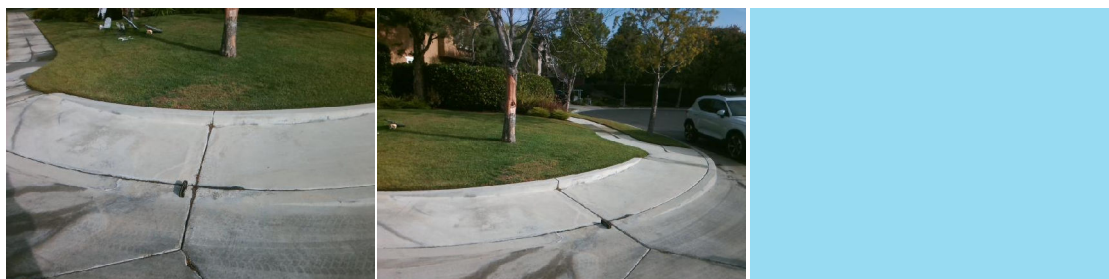

Compliance	Description	Data	Compliance	Description	Data
N/A	Ramp Length LT (in)	85	N/A	Ramp Length RT (in)	78
Yes	Ramp Width LT (in)	52	Yes	Ramp Width RT (in)	54
Yes	Ramp Run Slope LT (%)	5	Yes	Ramp Run Slope RT (%)	7.7
No	Ramp Cross Slope LT (%)	4.2	Yes	Ramp Cross Slope RT (%)	1
N/A	Landing Present	Yes	No	DWS Provided	No
N/A	Landing Length (in)	52	N/A	DWS Contrast	N/A
Yes	Landing Width (in)	50	N/A	DWS Length (in)	N/A
No	Landing Run Slope (%)	3.8	N/A	DWS Full Width	N/A
No	Landing Cross Slope (%)	2.6		DWS Offset Type	N/A
N/A	Landing Movement Obstructed?	No	N/A	DWS Offset Left (in)	N/A
	Landing Movement Type	Curb	N/A	DWS Offset Right (in)	N/A
N/A	Landing Shared	No			
N/A	Clear Space	Yes			
N/A	Clear Space To Crosswalk (in)	48			
N/A	Marked Crosswalk 1	No	N/A	Marked Crosswalk 2	No
	Crossing 1 Direction	W		Crossing 2 Direction	S
	Marked Crosswalk 1 Width (in)	N/A		Marked Crosswalk 2 Width (in)	N/A
N/A	Ramp Inside Crosswalk 1	N/A	N/A	Ramp Inside Crosswalk 2	N/A
	Crossing 1 Slope (%)	1		Crossing 2 Slope (%)	1.9
	Crossing 1 Cross Slope (%)	1.6		Crossing 2 Cross Slope (%)	1.9
Yes	Gutter Ponding	No	Yes	Curb Slope	5.8
Yes	Gutter Lip Height (in)	0		Road Run Slope (%)	0.7
Yes	Gutter Run Slope (%)	1.5		Road Cross Slope (%)	3.8
No	Gutter Cross Slope (%)	3	No	Perpendicular Joint Present	No
Yes	Overall Surface Condition	Acceptable			
	Cross Gutter Present?	Yes		Spandrel Present?	Yes
	Replace Cross Gutter?	No		Replace Spandrel?	No