




Access Compliance Report Public Rights-of-Way (Curb Ramps)



Main Street: HYDRANGEA_ST		Cross Street: BARBERRY_ST		Location:	NE
ADA ID: RPAT211102151157	Ramp Type:Type 1 - Perpendicular	Initial Pass/Fail: Pass	Overall Compliance: No	Severity Score:	35

Codes/Mitigation Info/Possible Solution			Field Measurements/Component Compliance		
---	--	--	---	--	--

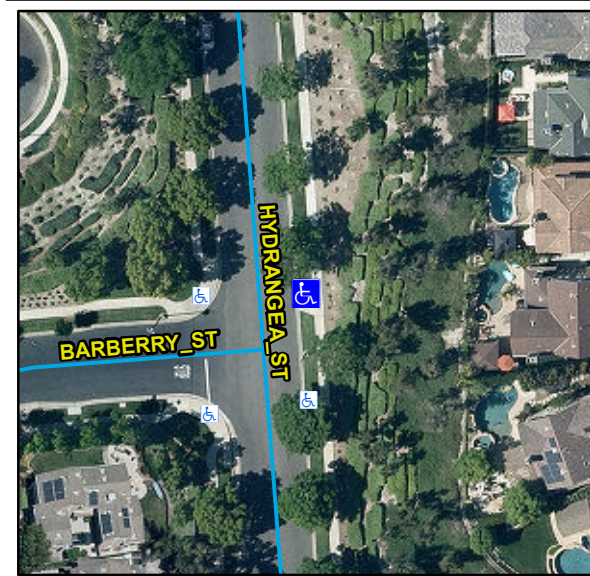

Possible Solutions:
Remove & Replace Entire Ramp. Remove & Replace Gutter.

Surveyor Notes:
N/A

OC Std/PROW:
R304.2.2, R304.5.3, R305, R304.5.4, STD 1115

Total Cost: \$ 3332

Parcel ID Number	741-051-36	Street 1 Name	HYDRANGEA_ST
Ramp Island Or Median	None	Stop Condition-Street 1	NoControl
Ramp Orientation	NonDiag	Street 2 Name	BARBERRY_ST
Google Street View Link:		Stop Condition-Street 2	N/A

http://www.google.com/maps/@?api=1&map_action=pano&viewpoint=33.54605813,-117.63319275

Obstruction and Utility Measurement/Component Compliance			
Compliance	Description	Data	Compliance Description Data
Yes	Obstructions Present?	No	N/A Utilities Present? No
	Obstruction Types	N/A	Utility Types
	Obstruction Dimensions	N/A	N/A

Compliance	Description	Data	Compliance	Description	Data
N/A	Ramp Length (in)	89	N/A	Flare Type LT	
Yes	Ramp Width (in)	50			Sloped
Yes	Ramp Run Slope (%)	8.2	N/A	Flare Slope LT (%)	2.4
No	Ramp Cross Slope (%)	5.5	N/A	Flare Traversable LT	No
N/A	Landing Present	Yes	N/A	Flare Type RT	
N/A	Landing Length (in)	60			Sloped
Yes	Landing Width (in)	50	N/A	Flare Slope RT (%)	17.4
Yes	Landing Run Slope (%)	1.9	N/A	Flare Traversable RT	No
No	Landing Cross Slope (%)	6	No	DWS Provided	No
N/A	Landing Movement Obstructed?	No	N/A	DWS Contrast	N/A
	Landing Movement Type	N/A	N/A	DWS Length (in)	N/A
N/A	Landing Shared	No	N/A	DWS Full Width	N/A
N/A	Clear Space	N/A	N/A	DWS Offset Left (in)	N/A
N/A	Clear Space To Crosswalk (in)	N/A	N/A	DWS Offset Right (in)	N/A
N/A	Marked Crosswalk 1	No	N/A	Marked Crosswalk 2	N/A
	Crossing 1 Direction	W		Crossing 2 Direction	N/A
	Marked Crosswalk 1 Width (in)	N/A		Marked Crosswalk 2 Width (in)	N/A
N/A	Ramp Inside Crosswalk 1	N/A	Yes	Ramp Inside Crosswalk 2	N/A
	Crossing 1 Slope (%)	1.5		Crossing 2 Slope (%)	N/A
	Crossing 1 Cross Slope (%)	6.6		Crossing 2 Cross Slope (%)	N/A
Yes	Gutter Ponding	No	No	Curb Slope	6.7
Yes	Gutter Lip Height (in)	0		Road Run Slope (%)	N/A
No	Gutter Run Slope (%)	11.2		Road Cross Slope (%)	N/A
No	Gutter Cross Slope (%)	6.5			
Yes	Overall Surface Condition: Acceptable		Yes	Perp Joint Present	Yes
	Cross Gutter Present?	No		Spandrel Present?	No
	Replace Cross Gutter?	N/A		Replace Spandrel?	N/A

