



# Access Compliance Report Public Rights-of-Way (Curb Ramps)




Main Street: ANTIGUA\_ST Cross Street: BIENVILLE\_AVE Location: NE

ADA ID: RPAT211118111739 Ramp Type: Type 4 - Parallel Initial Pass/Fail: Pass Overall Compliance: No Severity Score: 5

## Codes/Mitigation Info/Possible Solution

## Field Measurements/Component Compliance

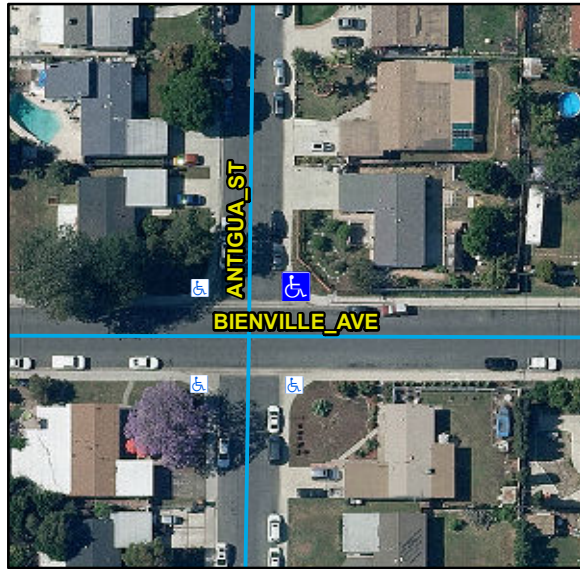

Possible Solutions:

Remove & Replace Gutter.

Surveyor Notes:

N/A

OC Std/PROW:

R304.5.4, STD 1115

Total Cost: \$ 252

Parcel ID Number 127-361-06  
Ramp Island Or Median None  
Ramp Orientation Diag  
Google Street View Link:

[http://www.google.com/maps/@?api=1&map\\_action=pano&viewpoint=33.81674953,-117.96173713](http://www.google.com/maps/@?api=1&map_action=pano&viewpoint=33.81674953,-117.96173713)

Street 1 Name ANTIGUA\_ST  
Stop Condition-Street 1 NoControl  
Street 2 Name BIENVILLE\_AVE  
Stop Condition-Street 2 NoControl

## Obstruction and Utility Measurement/Component Compliance

| Compliance | Description            | Data | Compliance | Description        | Data |
|------------|------------------------|------|------------|--------------------|------|
| Yes        | Obstructions Present?  | No   | N/A        | Utilities Present? | No   |
|            | Obstruction Types      | N/A  |            | Utility Types      |      |
|            | Obstruction Dimensions | N/A  |            |                    | N/A  |

| Compliance | Description                   | Data       | Compliance | Description                   | Data   |
|------------|-------------------------------|------------|------------|-------------------------------|--------|
| N/A        | Ramp Length LT (in)           | 76         | N/A        | Ramp Length RT (in)           | 76     |
| Yes        | Ramp Width LT (in)            | 55         | Yes        | Ramp Width RT (in)            | 55     |
| Yes        | Ramp Run Slope LT (%)         | 6.2        | Yes        | Ramp Run Slope RT (%)         | 6.7    |
| Yes        | Ramp Cross Slope LT (%)       | 0.5        | Yes        | Ramp Cross Slope RT (%)       | 0.2    |
| N/A        | Landing Present               | Yes        | Yes        | DWS Provided                  | Yes    |
| N/A        | Landing Length (in)           | 54         | Yes        | DWS Contrast                  | Yes    |
| Yes        | Landing Width (in)            | 48         | Yes        | DWS Length (in)               | 36     |
| Yes        | Landing Run Slope (%)         | 0.8        | Yes        | DWS Full Width                | Yes    |
| Yes        | Landing Cross Slope (%)       | 0.4        |            | DWS Offset Type               | Single |
| N/A        | Landing Movement Obstructed?  | No         | Yes        | DWS Offset Left (in)          | 0      |
|            | Landing Movement Type         | Curb       | Yes        | DWS Offset Right (in)         | N/A    |
| N/A        | Landing Shared                | No         |            |                               |        |
| N/A        | Clear Space                   | Yes        |            |                               |        |
| N/A        | Clear Space To Crosswalk (in) | 48         |            |                               |        |
| N/A        | Marked Crosswalk 1            | No         | N/A        | Marked Crosswalk 2            | No     |
|            | Crossing 1 Direction          | W          |            | Crossing 2 Direction          | S      |
|            | Marked Crosswalk 1 Width (in) | N/A        |            | Marked Crosswalk 2 Width (in) | N/A    |
| N/A        | Ramp Inside Crosswalk 1       | N/A        | N/A        | Ramp Inside Crosswalk 2       | N/A    |
|            | Crossing 1 Slope (%)          | 1.6        |            | Crossing 2 Slope (%)          | 2.8    |
|            | Crossing 1 Cross Slope (%)    | 1.1        |            | Crossing 2 Cross Slope (%)    | 0.1    |
| Yes        | Gutter Ponding                | No         | Yes        | Curb Slope                    | 5.8    |
| Yes        | Gutter Lip Height (in)        | 0          |            | Road Run Slope (%)            | 1.2    |
| No         | Gutter Run Slope (%)          | 5.2        |            | Road Cross Slope (%)          | 3.1    |
| Yes        | Gutter Cross Slope (%)        | 0.9        | Yes        | Perpendicular Joint Present   | Yes    |
| Yes        | Overall Surface Condition     | Acceptable |            |                               |        |
|            | Cross Gutter Present?         | Yes        |            | Spandrel Present?             | Yes    |
|            | Replace Cross Gutter?         | No         |            | Replace Spandrel?             | No     |

