



# Access Compliance Report Public Rights-of-Way (Curb Ramps)




Main Street: CHAPMAN\_AVE Cross Street: BEACH\_BLVD Location: NW

ADA ID: RPAT211130124405 Ramp Type: Type 4 - Parallel Initial Pass/Fail: Pass Overall Compliance: No Severity Score: 2

## Codes/Mitigation Info/Possible Solution

## Field Measurements/Component Compliance

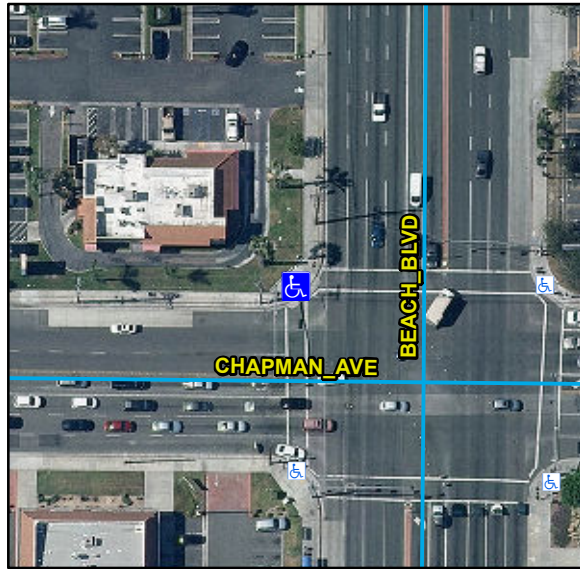

### Possible Solutions:

Remove & Replace Landing. Remove & Replace Sidewalk.

### Surveyor Notes:

N/A

### OC Std/PROW:

R304.5.3, R304.2.2-Perp, R304.3.2-Para, STD 1115

Total Cost: \$ 909

Parcel ID Number 131-254-17  
Ramp Island Or Median None  
Ramp Orientation Diag  
Google Street View Link:

[http://www.google.com/maps/@?api=1&map\\_action=pano&viewpoint=33.78852239,-117.99317593](http://www.google.com/maps/@?api=1&map_action=pano&viewpoint=33.78852239,-117.99317593)

Street 1 Name CHAPMAN\_AVE  
Stop Condition-Street 1 Signal  
Street 2 Name BEACH\_BLVD  
Stop Condition-Street 2 Signal

## Obstruction and Utility Measurement/Component Compliance

| Compliance | Description            | Data | Compliance | Description        | Data |
|------------|------------------------|------|------------|--------------------|------|
| Yes        | Obstructions Present?  | No   | N/A        | Utilities Present? | No   |
|            | Obstruction Types      | N/A  |            | Utility Types      |      |
|            | Obstruction Dimensions | N/A  |            |                    | N/A  |

| Compliance | Description                   | Data       | Compliance | Description                   | Data   |
|------------|-------------------------------|------------|------------|-------------------------------|--------|
| N/A        | Ramp Length LT (in)           | 93         | N/A        | Ramp Length RT (in)           | 94     |
| Yes        | Ramp Width LT (in)            | 139        | Yes        | Ramp Width RT (in)            | 120    |
| Yes        | Ramp Run Slope LT (%)         | 0.2        | Yes        | Ramp Run Slope RT (%)         | 4      |
| Yes        | Ramp Cross Slope LT (%)       | 0.7        | No         | Ramp Cross Slope RT (%)       | 2.7    |
| N/A        | Landing Present               | Yes        | Yes        | DWS Provided                  | Yes    |
| N/A        | Landing Length (in)           | 120        | Yes        | DWS Contrast                  | Yes    |
| Yes        | Landing Width (in)            | 59         | Yes        | DWS Length (in)               | 36     |
| No         | Landing Run Slope (%)         | 2.3        | Yes        | DWS Full Width                | Yes    |
| Yes        | Landing Cross Slope (%)       | 0          |            | DWS Offset Type               | Single |
| N/A        | Landing Movement Obstructed?  | No         | Yes        | DWS Offset Left (in)          | 1      |
|            | Landing Movement Type         | Curb       | Yes        | DWS Offset Right (in)         | N/A    |
| N/A        | Landing Shared                | No         |            |                               |        |
| Yes        | Clear Space                   | Yes        |            |                               |        |
| Yes        | Clear Space To Crosswalk (in) | 48         |            |                               |        |
| N/A        | Marked Crosswalk 1            | Yes        | N/A        | Marked Crosswalk 2            | Yes    |
|            | Crossing 1 Direction          | S          |            | Crossing 2 Direction          | E      |
|            | Marked Crosswalk 1 Width (in) | 120        |            | Marked Crosswalk 2 Width (in) | 120    |
| Yes        | Ramp Inside Crosswalk 1       | Yes        | Yes        | Ramp Inside Crosswalk 2       | Yes    |
|            | Crossing 1 Slope (%)          | 3.4        |            | Crossing 2 Slope (%)          | 1.7    |
|            | Crossing 1 Cross Slope (%)    | 4.2        |            | Crossing 2 Cross Slope (%)    | 0.7    |
| Yes        | Gutter Ponding                | No         | Yes        | Curb Slope                    | 7.3    |
| Yes        | Gutter Lip Height (in)        | 0          |            | Road Run Slope (%)            | 5.4    |
| Yes        | Gutter Run Slope (%)          | 0.3        |            | Road Cross Slope (%)          | 0.1    |
| Yes        | Gutter Cross Slope (%)        | 2.1        | Yes        | Perpendicular Joint Present   | Yes    |
| Yes        | Overall Surface Condition     | Acceptable |            |                               |        |
|            | Cross Gutter Present?         | No         |            | Spandrel Present?             | No     |
|            | Replace Cross Gutter?         | N/A        |            | Replace Spandrel?             | N/A    |

