




# Access Compliance Report Public Rights-of-Way (Curb Ramps)

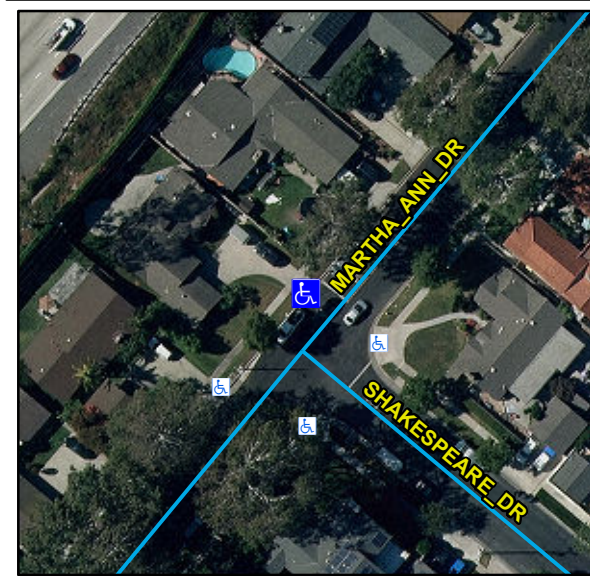

|                                         |                    |                             |                                         |                 |     |
|-----------------------------------------|--------------------|-----------------------------|-----------------------------------------|-----------------|-----|
| Main Street: MARTHA_ANN_DR              |                    | Cross Street: MARTHA_ANN_DR |                                         | Location:       | S   |
| ADA ID: RPAT211201104229                | Ramp Type: No Ramp | Initial Pass/Fail: N/A      | Overall Compliance: No                  | Severity Score: | 100 |
| Codes/Mitigation Info/Possible Solution |                    |                             | Field Measurements/Component Compliance |                 |     |



Possible Solutions:

Provide Curb Ramp

Surveyor Notes:

N/A

OC Std/PROW:

STD 1115

Total Cost: \$ 3080

|                          |            |                         |               |
|--------------------------|------------|-------------------------|---------------|
| Parcel ID Number         | 086-355-02 | Street 1 Name           | MARTHA_ANN_DR |
| Ramp Island Or Median    | N/A        | Stop Condition-Street 1 | N/A           |
| Ramp Orientation         | N/A        | Street 2 Name           | MARTHA_ANN_DR |
| Google Street View Link: |            | Stop Condition-Street 2 | N/A           |

[http://www.google.com/maps/@?api=1&map\\_action=pano&viewpoint=33.79875565,-118.08411272](http://www.google.com/maps/@?api=1&map_action=pano&viewpoint=33.79875565,-118.08411272)



| Compliance | Description | Data | Compliance | Description | Data |
|------------|-------------|------|------------|-------------|------|
|            |             |      |            |             |      |