




Access Compliance Report Public Rights-of-Way (Curb Ramps)

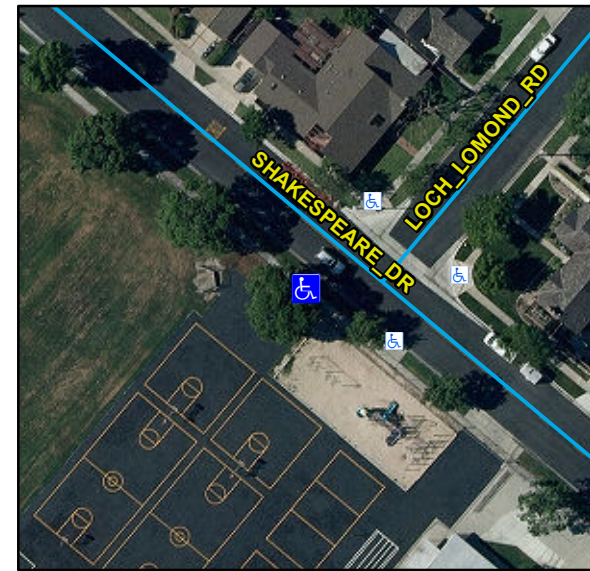

Main Street: SHAKESPEARE_DR		Cross Street: SHAKESPEARE_DR		Location:	E
ADA ID: RPAT211201114649	Ramp Type: No Ramp	Initial Pass/Fail: N/A	Overall Compliance: No	Severity Score:	100
Codes/Mitigation Info/Possible Solution			Field Measurements/Component Compliance		



Possible Solutions:

Provide Curb Ramp

Surveyor Notes:

N/A

OC Std/PROW:

STD 1115

Total Cost: \$ 3080

Parcel ID Number 086-343-01
Ramp Island Or Median N/A
Ramp Orientation N/A
Google Street View Link:

Street 1 Name SHAKESPEARE_DR
Stop Condition-Street 1 N/A
Street 2 Name SHAKESPEARE_DR
Stop Condition-Street 2 N/A

http://www.google.com/maps/@?api=1&map_action=pano&viewpoint=33.79720974,-118.08209816

Compliance	Description	Data	Compliance	Description	Data

