




Access Compliance Report Public Rights-of-Way (Curb Ramps)



Main Street: FRONTERA_ST		Cross Street: N_GLASSELL_ST		Location:	NE
ADA ID: RPAT220127092606	Ramp Type:Type 1 - Perpendicular	Initial Pass/Fail: Fail	Overall Compliance: No	Severity Score:	20

Codes/Mitigation Info/Possible Solution			Field Measurements/Component Compliance		
---	--	--	---	--	--

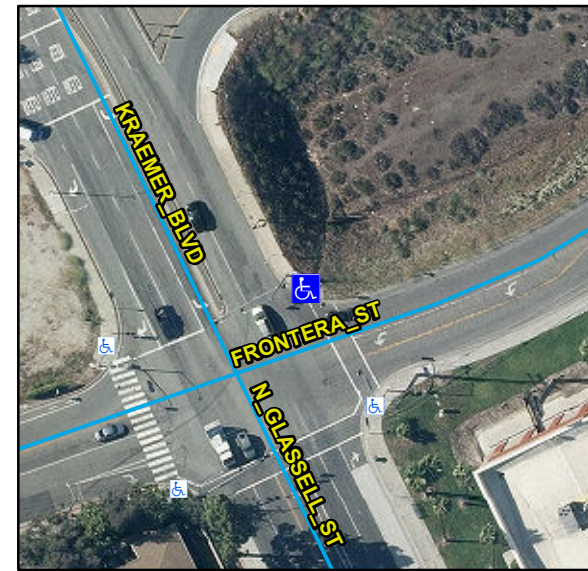

Possible Solutions:

Remove & Replace Entire Ramp. Restripe Crosswalk.

Surveyor Notes:

N/A

OC Std/PROW:

R304.2.2, R204.3, R304.5.1, R304.5.3, R302.7, STD 1115

Total Cost: \$ 7080

Parcel ID Number	360-061-13	Street 1 Name	FRONTERA_ST
Ramp Island Or Median	None	Stop Condition-Street 1	Signal
Ramp Orientation	NonDiag	Street 2 Name	N_GLASSELL_ST
Google Street View Link:		Stop Condition-Street 2	N/A

http://www.google.com/maps/@?api=1&map_action=pano&viewpoint=33.84644515,-117.85440158

Obstruction and Utility Measurement/Component Compliance

Compliance	Description	Data	Compliance	Description	Data
Yes	Obstructions Present?	No	N/A	Utilities Present?	No
	Obstruction Types	N/A		Utility Types	
	Obstruction Dimensions	N/A			N/A

Compliance	Description	Data	Compliance	Description	Data
N/A	Ramp Length (in)	111	N/A	Flare Type LT	
No	Ramp Width (in)	45			N/A
Yes	Ramp Run Slope (%)	5.1	N/A	Flare Slope LT (%)	N/A
No	Ramp Cross Slope (%)	2.5	N/A	Flare Traversable LT	N/A
N/A	Landing Present	N/A	N/A	Flare Type RT	
N/A	Landing Length (in)	N/A			N/A
N/A	Landing Width (in)	N/A	N/A	Flare Slope RT (%)	N/A
N/A	Landing Run Slope (%)	N/A	N/A	Flare Traversable RT	N/A
N/A	Landing Cross Slope (%)	N/A	N/A	DWS Provided	N/A
N/A	Landing Movement Obstructed?	N/A	N/A	DWS Contrast	N/A
	Landing Movement Type	N/A	N/A	DWS Length (in)	N/A
N/A	Landing Shared	N/A	N/A	DWS Full Width	N/A
N/A	Clear Space	N/A	N/A	DWS Offset Left (in)	N/A
N/A	Clear Space To Crosswalk (in)	N/A	N/A	DWS Offset Right (in)	N/A
N/A	Marked Crosswalk 1	Yes	N/A	Marked Crosswalk 2	N/A
	Crossing 1 Direction	S		Crossing 2 Direction	N/A
	Marked Crosswalk 1 Width (in)	128		Marked Crosswalk 2 Width (in)	N/A
N/A	Ramp Inside Crosswalk 1	No	Yes	Ramp Inside Crosswalk 2	N/A
	Crossing 1 Slope (%)	4		Crossing 2 Slope (%)	N/A
	Crossing 1 Cross Slope (%)	0.1		Crossing 2 Cross Slope (%)	N/A
N/A	Gutter Ponding	N/A	No	Curb Slope	9.9
Yes	Gutter Lip Height (in)	0		Road Run Slope (%)	N/A
N/A	Gutter Run Slope (%)	N/A		Road Cross Slope (%)	N/A
N/A	Gutter Cross Slope (%)	N/A			
No	Overall Surface Condition:	Poor	No	Perp Joint Present	No
	Cross Gutter Present?	No		Spandrel Present?	No
	Replace Cross Gutter?	N/A		Replace Spandrel?	N/A

