



Access Compliance Report Public Rights-of-Way (Curb Ramps)




Main Street: N/A Cross Street: LINCOLN_AVE Location: NW

ADA ID: RPAT220127115547 Ramp Type: Type 7 - Directional 2 Initial Pass/Fail: Fail Overall Compliance: No Severity Score: 2

Codes/Mitigation Info/Possible Solution

Field Measurements/Component Compliance

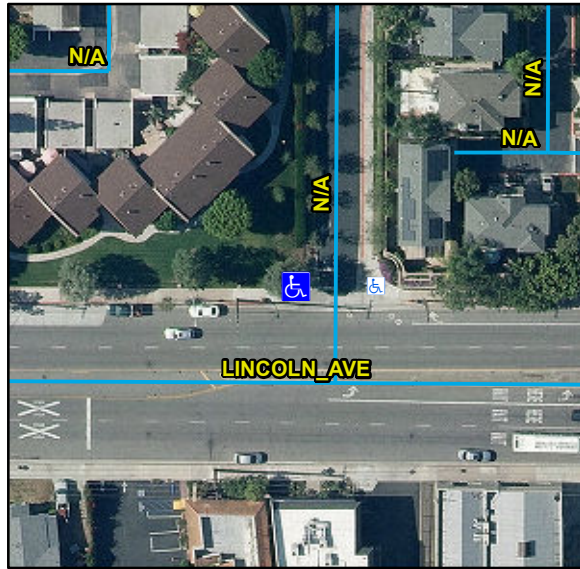

Possible Solutions:

Remove & Replace Entire Ramp.

Surveyor Notes:

N/A

OC Std/PROW:

R304.5.3, STD 1115

Total Cost:

\$ 3080

Parcel ID Number 360-043-56
Ramp Island Or Median None
Ramp Orientation NonDiag
Google Street View Link:

http://www.google.com/maps/@?api=1&map_action=pano&viewpoint=33.83632472,-117.84722459

Street 1 Name N/A
Stop Condition-Street 1 StopSign
Street 2 Name LINCOLN_AVE
Stop Condition-Street 2 N/A

Obstruction and Utility Measurement/Component Compliance

Compliance	Description	Data	Compliance	Description	Data
Yes	Obstructions Present?	No	N/A	Utilities Present?	No
	Obstruction Types	N/A		Utility Types	
	Obstruction Dimensions	N/A			N/A

Compliance	Description	Data	Compliance	Description	Data
N/A	Ramp Length (in)	118	N/A	Flare Type LT	
Yes	Ramp Width (in)	82			None
Yes	Ramp Run Slope (%)	7.5	N/A	Flare Slope LT (%)	N/A
No	Ramp Cross Slope (%)	2.2	N/A	Flare Traversable LT	N/A
N/A	Grade Break	Yes	N/A	Flare Type RT	
N/A	Grade Break Slope (%)	0			Curbed2
N/A	Grade Break Cross Slope (%)	0.9	N/A	Flare Slope RT (%)	N/A
	Addl Para Ramp Left?	No	N/A	Flare Traversable RT	N/A
	Addl Para Ramp Right?	No	N/A	DWS Provided	Yes
N/A	Landing Present	No	N/A	DWS Contrast	Yes
N/A	Landing Length (in)	N/A	N/A	DWS Length (in)	41
N/A	Landing Width (in)	N/A	N/A	DWS Full Width	Yes
N/A	Landing Run Slope (%)	N/A		DWS Offset Type	Single
N/A	Landing Cross Slope (%)	N/A	N/A	DWS Left Offset (in)	0
N/A	Landing Movement Obstructed?	No	N/A	DWS Right Offset (in)	N/A
	Landing Movement Type	N/A			
N/A	Landing Shared	N/A			
N/A	Marked Crosswalk 1	No	N/A	Clear Space	N/A
	Crossing 1 Direction	E	N/A	Clear Space To Crosswalk (in)	N/A
	Marked Crosswalk 1 Width (in)	N/A			
N/A	Ramp Inside Crosswalk 1	N/A			
	Crossing 1 Slope (%)	0.7			
	Crossing 1 Cross Slope (%)	0			
N/A	Gutter Ponding	No	N/A	Curb Slope	12.2
Yes	Gutter Lip Height (in)	0		Road Run Slope (%)	N/A
N/A	Gutter Run Slope (%)	0.7		Road Cross Slope (%)	N/A
N/A	Gutter Cross Slope (%)	5.4		Parallel Ramp Side	Right
Yes	Overall Surface Condition	Acceptable	Yes	Perp Joint Present	Yes
	Cross Gutter Present?	Yes		Spandrel Present?	Yes
	Replace Cross Gutter?	No		Replace Spandrel?	No

