



Access Compliance Report Public Rights-of-Way (Curb Ramps)




Main Street: CERRITOS_AVE Cross Street: BROOKHURST_ST Location: NE

ADA ID: RPAT220202143245 Ramp Type: Type 1 - Perpendicular Diagonal Initial Pass/Fail: Pass Overall Compliance: No Severity Score: 0

Codes/Mitigation Info/Possible Solution

Field Measurements/Component Compliance

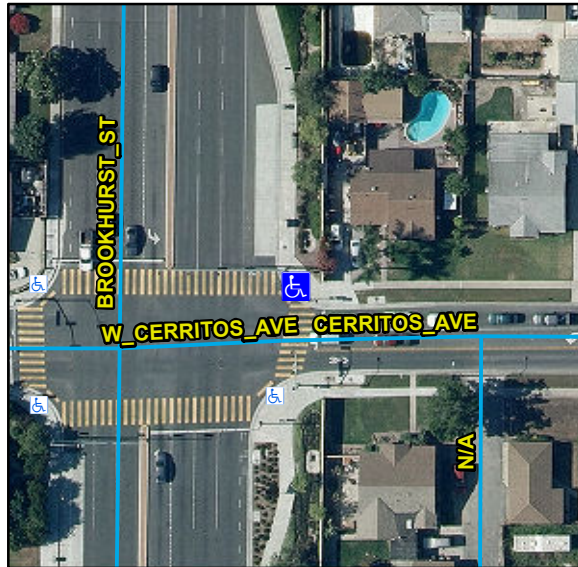

Possible Solutions:

Remove & Replace Curb Slope.

Surveyor Notes:

N/A

OC Std/PROW:

R304.2.2, STD 1115

Total Cost: \$ 252

Parcel ID Number 128-431-01
Ramp Island Or Median None
Ramp Orientation Diag
Google Street View Link:

Street 1 Name CERRITOS_AVE
Stop Condition-Street 1 Signal
Street 2 Name BROOKHURST_ST
Stop Condition-Street 2 Signal

http://www.google.com/maps/@?api=1&map_action=pano&viewpoint=33.81059319,-117.95859847

Obstruction and Utility Measurement/Component Compliance

Compliance	Description	Data	Compliance	Description	Data
Yes	Obstructions Present?	No	N/A	Utilities Present?	No
	Obstruction Types	N/A		Utility Types	
	Obstruction Dimensions	N/A			N/A

Compliance	Description	Data	Compliance	Description	Data
N/A	Ramp Length (in)	89	N/A	Flare Type LT	
Yes	Ramp Width (in)	48			Sloped
Yes	Ramp Run Slope (%)	7.8	N/A	Flare Slope LT (%)	5.4
Yes	Ramp Cross Slope (%)	0	N/A	Flare Traversable LT	No
N/A	Landing Present	Yes	N/A	Flare Type RT	
N/A	Landing Length (in)	61			Sloped
Yes	Landing Width (in)	48	N/A	Flare Slope RT (%)	6.5
Yes	Landing Run Slope (%)	1.3	N/A	Flare Traversable RT	No
Yes	Landing Cross Slope (%)	1.2	Yes	DWS Provided	Yes
N/A	Landing Movement Obstructed?	No	Yes	DWS Contrast	Yes
	Landing Movement Type	N/A	Yes	DWS Length (in)	36
N/A	Landing Shared	Yes	Yes	DWS Full Width	Yes
Yes	Clear Space	Yes	Yes	DWS Offset Left (in)	0
Yes	Clear Space To Crosswalk (in)	48	Yes	DWS Offset Right (in)	N/A
N/A	Marked Crosswalk 1	Yes	N/A	Marked Crosswalk 2	Yes
	Crossing 1 Direction	W		Crossing 2 Direction	S
	Marked Crosswalk 1 Width (in)	150		Marked Crosswalk 2 Width (in)	150
Yes	Ramp Inside Crosswalk 1	Yes	Yes	Ramp Inside Crosswalk 2	Yes
	Crossing 1 Slope (%)	0.9		Crossing 2 Slope (%)	1.5
	Crossing 1 Cross Slope (%)	1		Crossing 2 Cross Slope (%)	1
Yes	Gutter Ponding	No	No	Curb Slope	8.5
Yes	Gutter Lip Height (in)	0		Road Run Slope (%)	0.3
Yes	Gutter Run Slope (%)	3.6		Road Cross Slope (%)	1.3
Yes	Gutter Cross Slope (%)	0.9			
Yes	Overall Surface Condition: Acceptable		Yes	Perp Joint Present	Yes
	Cross Gutter Present?	No		Spandrel Present?	No
	Replace Cross Gutter?	N/A		Replace Spandrel?	N/A

