




Access Compliance Report Public Rights-of-Way (Curb Ramps)



Main Street: ANTIGUA_ST Cross Street: GUINIDA_LN Location: NE

ADA ID: RPAT220203112009 Ramp Type: Type 4 - Parallel Initial Pass/Fail: Pass Overall Compliance: Yes Severity Score: 0

Codes/Mitigation Info/Possible Solution Field Measurements/Component Compliance

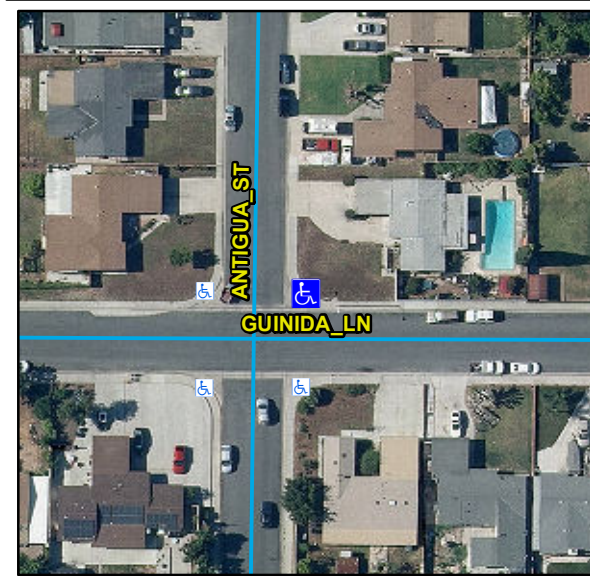

Possible Solutions:
N/A

Surveyor Notes:
N/A

OC Std/PROW:
N/A

Total Cost: \$ 0

Parcel ID Number 127-362-14
Ramp Island Or Median None
Ramp Orientation Diag
Google Street View Link:
http://www.google.com/maps/@?api=1&map_action=pano&viewpoint=33.81439872,-117.96171953

Street 1 Name ANTIGUA_ST
Stop Condition-Street 1 NoControl
Street 2 Name GUINIDA_LN
Stop Condition-Street 2 NoControl

Compliance	Description	Data	Compliance	Description	Data
N/A	Ramp Length LT (in)	86	N/A	Ramp Length RT (in)	83
Yes	Ramp Width LT (in)	55	Yes	Ramp Width RT (in)	54
Yes	Ramp Run Slope LT (%)	7.4	Yes	Ramp Run Slope RT (%)	6.6
Yes	Ramp Cross Slope LT (%)	0.4	Yes	Ramp Cross Slope RT (%)	1.3
N/A	Landing Present	Yes	Yes	DWS Provided	Yes
N/A	Landing Length (in)	54	Yes	DWS Contrast	Yes
Yes	Landing Width (in)	48	Yes	DWS Length (in)	36
Yes	Landing Run Slope (%)	0.7	Yes	DWS Full Width	Yes
Yes	Landing Cross Slope (%)	0.6		DWS Offset Type	Single
N/A	Landing Movement Obstructed?	No	Yes	DWS Offset Left (in)	0
	Landing Movement Type	Curb	Yes	DWS Offset Right (in)	N/A
N/A	Landing Shared	No			
N/A	Clear Space	Yes			
N/A	Clear Space To Crosswalk (in)	48			
N/A	Marked Crosswalk 1	No	N/A	Marked Crosswalk 2	No
	Crossing 1 Direction	W		Crossing 2 Direction	S
	Marked Crosswalk 1 Width (in)	N/A		Marked Crosswalk 2 Width (in)	N/A
N/A	Ramp Inside Crosswalk 1	N/A	N/A	Ramp Inside Crosswalk 2	N/A
	Crossing 1 Slope (%)	4.2		Crossing 2 Slope (%)	3.1
	Crossing 1 Cross Slope (%)	1.4		Crossing 2 Cross Slope (%)	2.3
Yes	Gutter Ponding	No	Yes	Curb Slope	4.8
Yes	Gutter Lip Height (in)	0		Road Run Slope (%)	2.8
Yes	Gutter Run Slope (%)	2.4		Road Cross Slope (%)	0
Yes	Gutter Cross Slope (%)	1	Yes	Perpendicular Joint Present	Yes
Yes	Overall Surface Condition	Acceptable			
	Cross Gutter Present?	Yes		Spandrel Present?	Yes
	Replace Cross Gutter?	No		Replace Spandrel?	No

Obstruction and Utility Measurement/Component Compliance					
Compliance	Description	Data	Compliance	Description	Data
Yes	Obstructions Present?	No	N/A	Utilities Present?	No
	Obstruction Types	N/A		Utility Types	
	Obstruction Dimensions	N/A			N/A

