




Access Compliance Report Public Rights-of-Way (Curb Ramps)



Main Street: N/A Cross Street: CERRITOS_AVE Location: NW

ADA ID: RPAT220203145821 Ramp Type: Type 1 - Perpendicular Initial Pass/Fail: Pass Overall Compliance: No Severity Score: 4

Codes/Mitigation Info/Possible Solution Field Measurements/Component Compliance

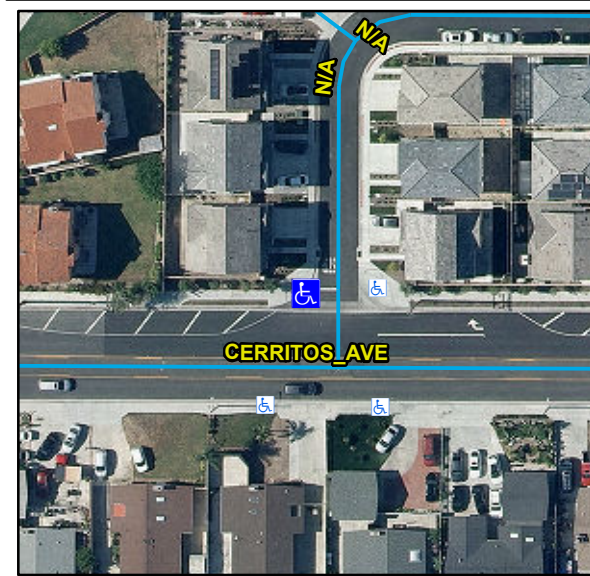

Possible Solutions:
Remove & Replace Landing.

Surveyor Notes:
N/A

OC Std/PROW:
R304.2.1, STD 1115

Total Cost: \$ 531

Parcel ID Number **127-403-30**
Ramp Island Or Median **None**
Ramp Orientation **NonDiag**
Google Street View Link:
http://www.google.com/maps/@?api=1&map_action=pano&viewpoint=33.81053563,-117.96551542

Street 1 Name **N/A**
Stop Condition-Street 1 **StopSign**
Street 2 Name **CERRITOS_AVE**
Stop Condition-Street 2 **N/A**

Compliance	Description	Data	Compliance	Description	Data
N/A	Ramp Length (in)	87	N/A	Flare Type LT	
Yes	Ramp Width (in)	48			Sloped
Yes	Ramp Run Slope (%)	7.3	N/A	Flare Slope LT (%)	8.4
Yes	Ramp Cross Slope (%)	0.3	N/A	Flare Traversable LT	No
N/A	Landing Present	Yes	N/A	Flare Type RT	
N/A	Landing Length (in)	37			Sloped
Yes	Landing Width (in)	48	N/A	Flare Slope RT (%)	10.6
Yes	Landing Run Slope (%)	0.3	N/A	Flare Traversable RT	No
Yes	Landing Cross Slope (%)	0	Yes	DWS Provided	Yes
N/A	Landing Movement Obstructed?	No	Yes	DWS Contrast	Yes
	Landing Movement Type	N/A	Yes	DWS Length (in)	36
N/A	Landing Shared	No	Yes	DWS Full Width	Yes
N/A	Clear Space	N/A	Yes	DWS Offset Left (in)	0
N/A	Clear Space To Crosswalk (in)	N/A	Yes	DWS Offset Right (in)	N/A
N/A	Marked Crosswalk 1	No	N/A	Marked Crosswalk 2	N/A
	Crossing 1 Direction	E		Crossing 2 Direction	N/A
	Marked Crosswalk 1 Width (in)	N/A		Marked Crosswalk 2 Width (in)	N/A
N/A	Ramp Inside Crosswalk 1	N/A	Yes	Ramp Inside Crosswalk 2	N/A
	Crossing 1 Slope (%)	0.9		Crossing 2 Slope (%)	N/A
	Crossing 1 Cross Slope (%)	2.2		Crossing 2 Cross Slope (%)	N/A
Yes	Gutter Ponding	No	Yes	Curb Slope	4.2
Yes	Gutter Lip Height (in)	0		Road Run Slope (%)	N/A
Yes	Gutter Run Slope (%)	0.5		Road Cross Slope (%)	N/A
Yes	Gutter Cross Slope (%)	0.7			
Yes	Overall Surface Condition: Acceptable		Yes	Perp Joint Present	Yes
	Cross Gutter Present?	Yes		Spandrel Present?	Yes
	Replace Cross Gutter?	No		Replace Spandrel?	No

Obstruction and Utility Measurement/Component Compliance					
Compliance	Description	Data	Compliance	Description	Data
Yes	Obstructions Present?	No	N/A	Utilities Present?	No
	Obstruction Types	N/A		Utility Types	
	Obstruction Dimensions	N/A			N/A

