



Access Compliance Report Public Rights-of-Way (Curb Ramps)




Main Street: VALENCIA_AVE Cross Street: SANTE_FE_AVE Location: NE

ADA ID: RPAT220218171919 Ramp Type: Type 1 - Perpendicular Diagonal Initial Pass/Fail: Fail Overall Compliance: No Severity Score: 5

Codes/Mitigation Info/Possible Solution

Field Measurements/Component Compliance

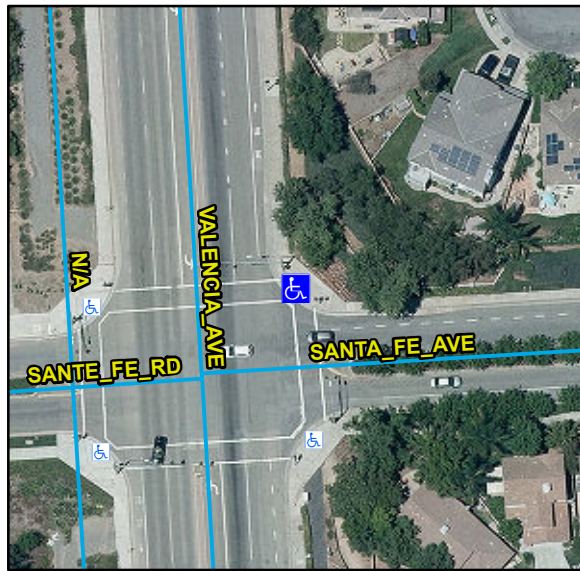

Possible Solutions:

Remove & Replace Curb Ramp With Two New Directional Ramps or Equivalent.

Surveyor Notes:

N/A

OC Std/PROW:

R304.2.2, R304.5.1, R304.5.3, STD 1115

Total Cost: \$ 6160

Parcel ID Number 308-092-67
Ramp Island Or Median None
Ramp Orientation Diag
Google Street View Link:

http://www.google.com/maps/@?api=1&map_action=pano&viewpoint=33.92809009,-117.84784817

Street 1 Name VALENCIA_AVE
Stop Condition-Street 1 Signal
Street 2 Name SANTE_FE_AVE
Stop Condition-Street 2 Signal

Obstruction and Utility Measurement/Component Compliance

Compliance	Description	Data	Compliance	Description	Data
Yes	Obstructions Present?	No	N/A	Utilities Present?	No
	Obstruction Types	N/A		Utility Types	
	Obstruction Dimensions	N/A			N/A

Compliance	Description	Data	Compliance	Description	Data
N/A	Ramp Length (in)	125	N/A	Flare Type LT	
No	Ramp Width (in)	45			N/A
Yes	Ramp Run Slope (%)	0.5	N/A	Flare Slope LT (%)	N/A
No	Ramp Cross Slope (%)	5	N/A	Flare Traversable LT	N/A
N/A	Landing Present	N/A	N/A	Flare Type RT	
N/A	Landing Length (in)	N/A			N/A
N/A	Landing Width (in)	N/A	N/A	Flare Slope RT (%)	N/A
N/A	Landing Run Slope (%)	N/A	N/A	Flare Traversable RT	N/A
N/A	Landing Cross Slope (%)	N/A	N/A	DWS Provided	N/A
N/A	Landing Movement Obstructed?	N/A	N/A	DWS Contrast	N/A
	Landing Movement Type	N/A	N/A	DWS Length (in)	N/A
N/A	Landing Shared	N/A	N/A	DWS Full Width	N/A
N/A	Clear Space	Yes	N/A	DWS Offset Left (in)	N/A
N/A	Clear Space To Crosswalk (in)	48	N/A	DWS Offset Right (in)	N/A
N/A	Marked Crosswalk 1	Yes	N/A	Marked Crosswalk 2	Yes
	Crossing 1 Direction	SE		Crossing 2 Direction	NW
	Marked Crosswalk 1 Width (in)	132		Marked Crosswalk 2 Width (in)	132
N/A	Ramp Inside Crosswalk 1	Yes	Yes	Ramp Inside Crosswalk 2	Yes
	Crossing 1 Slope (%)	1.2		Crossing 2 Slope (%)	4.2
	Crossing 1 Cross Slope (%)	2.6		Crossing 2 Cross Slope (%)	5.2
N/A	Gutter Ponding	N/A	No	Curb Slope	9.8
Yes	Gutter Lip Height (in)	0		Road Run Slope (%)	2.5
N/A	Gutter Run Slope (%)	N/A		Road Cross Slope (%)	5.4
N/A	Gutter Cross Slope (%)	N/A			
Yes	Overall Surface Condition: Acceptable		Yes	Perp Joint Present	Yes
	Cross Gutter Present?	No		Spandrel Present?	No
	Replace Cross Gutter?	N/A		Replace Spandrel?	N/A

