



Access Compliance Report Public Rights-of-Way (Curb Ramps)




Main Street: YORBA_LINDA_BLVD Cross Street: KELLOGG_DR Location: NW

ADA ID: RPAT220221104016 Ramp Type: Type 4 - Parallel Initial Pass/Fail: Fail Overall Compliance: No Severity Score: 0

Codes/Mitigation Info/Possible Solution

Field Measurements/Component Compliance

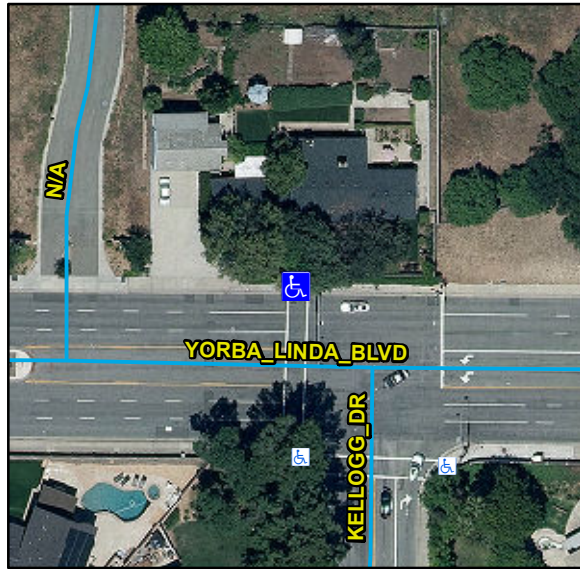

Possible Solutions:

Remove & Replace Entire Ramp.

Surveyor Notes:

N/A

OC Std/PROW:

STD 1115

Total Cost: \$ 2000

Parcel ID Number 323-431-13
Ramp Island Or Median None
Ramp Orientation NonDiag
Google Street View Link:

http://www.google.com/maps/@?api=1&map_action=pano&viewpoint=33.88882016,-117.79532906

Street 1 Name YORBA_LINDA_BLVD
Stop Condition-Street 1 Signal
Street 2 Name KELLOGG_DR
Stop Condition-Street 2 N/A

Obstruction and Utility Measurement/Component Compliance

Compliance	Description	Data	Compliance	Description	Data
Yes	Obstructions Present?	No	N/A	Utilities Present?	Yes
	Obstruction Types	N/A		Utility Types	
	Obstruction Dimensions	N/A		Pull Box	

Compliance	Description	Data	Compliance	Description	Data
N/A	Ramp Length LT (in)	105	N/A	Ramp Length RT (in)	272
Yes	Ramp Width LT (in)	96	Yes	Ramp Width RT (in)	52
Yes	Ramp Run Slope LT (%)	2.2	Yes	Ramp Run Slope RT (%)	6.8
Yes	Ramp Cross Slope LT (%)	1.5	Yes	Ramp Cross Slope RT (%)	1.6
N/A	Landing Present	Yes	N/A	DWS Provided	Yes
N/A	Landing Length (in)	96	N/A	DWS Contrast	Yes
N/A	Landing Width (in)	60	N/A	DWS Length (in)	45
N/A	Landing Run Slope (%)	1.5	N/A	DWS Full Width	Yes
N/A	Landing Cross Slope (%)	3.3		DWS Offset Type	Single
N/A	Landing Movement Obstructed?	Yes	N/A	DWS Offset Left (in)	0
	Landing Movement Type	Wall	N/A	DWS Offset Right (in)	N/A
N/A	Landing Shared	Yes			
N/A	Clear Space	N/A			
N/A	Clear Space To Crosswalk (in)	N/A			
N/A	Marked Crosswalk 1	Yes	N/A	Marked Crosswalk 2	N/A
	Crossing 1 Direction	SW		Crossing 2 Direction	N/A
N/A	Marked Crosswalk 1 Width (in)	168		Marked Crosswalk 2 Width (in)	N/A
N/A	Ramp Inside Crosswalk 1	Yes	N/A	Ramp Inside Crosswalk 2	N/A
	Crossing 1 Slope (%)	7.5		Crossing 2 Slope (%)	N/A
	Crossing 1 Cross Slope (%)	4.7		Crossing 2 Cross Slope (%)	N/A
N/A	Gutter Ponding	No	Yes	Curb Slope	5.5
Yes	Gutter Lip Height (in)	0		Road Run Slope (%)	N/A
N/A	Gutter Run Slope (%)	5.3		Road Cross Slope (%)	N/A
N/A	Gutter Cross Slope (%)	2.8	Yes	Perpendicular Joint Present	Yes
Yes	Overall Surface Condition	Acceptable			
	Cross Gutter Present?	Yes		Spandrel Present?	No
	Replace Cross Gutter?	No		Replace Spandrel?	N/A

