



Access Compliance Report Public Rights-of-Way (Curb Ramps)




Main Street: N/A Cross Street: GARZA_AVE Location: E

ADA ID: RPRK210920141301 Ramp Type: Type 1 - Perpendicular Diagonal Initial Pass/Fail: Pass Overall Compliance: No Severity Score: 0

Codes/Mitigation Info/Possible Solution

Field Measurements/Component Compliance

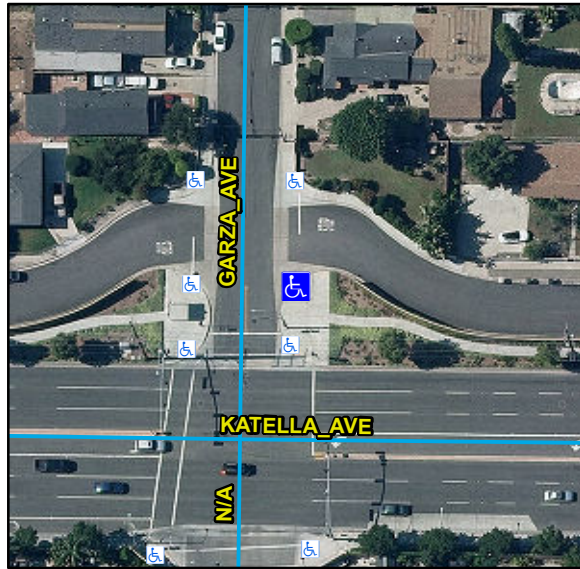

Possible Solutions:

Remove & Replace Gutter.

Surveyor Notes:

N/A

OC Std/PROW:

R304.5.3, STD 1115

Total Cost:

\$ 252

Parcel ID Number 127-561-24

Ramp Island Or Median None

Ramp Orientation Diag

Google Street View Link:

http://www.google.com/maps/@?api=1&map_action=pano&viewpoint=33.80330669,-117.9699679

Street 1 Name N/A

Stop Condition-Street 1 StopSign

Street 2 Name GARZA_AVE

Stop Condition-Street 2 NoControl

Obstruction and Utility Measurement/Component Compliance

Compliance	Description	Data	Compliance	Description	Data
Yes	Obstructions Present?	No	N/A	Utilities Present?	No
	Obstruction Types	N/A		Utility Types	
	Obstruction Dimensions	N/A			N/A

Compliance	Description	Data	Compliance	Description	Data
N/A	Ramp Length (in)	125	N/A	Flare Type LT	
Yes	Ramp Width (in)	48			Sloped
Yes	Ramp Run Slope (%)	5.1	Yes	Flare Slope LT (%)	4.9
Yes	Ramp Cross Slope (%)	1.1	N/A	Flare Traversable LT	Yes
N/A	Landing Present	Yes	N/A	Flare Type RT	
N/A	Landing Length (in)	48			Sloped
Yes	Landing Width (in)	48	Yes	Flare Slope RT (%)	4.4
Yes	Landing Run Slope (%)	1	N/A	Flare Traversable RT	Yes
Yes	Landing Cross Slope (%)	0.2	Yes	DWS Provided	Yes
N/A	Landing Movement Obstructed?	No	Yes	DWS Contrast	Yes
	Landing Movement Type	N/A	Yes	DWS Length (in)	36
N/A	Landing Shared	No	Yes	DWS Full Width	Yes
N/A	Clear Space	Yes	Yes	DWS Offset Left (in)	0
N/A	Clear Space To Crosswalk (in)	48	Yes	DWS Offset Right (in)	N/A
N/A	Marked Crosswalk 1	No	N/A	Marked Crosswalk 2	No
	Crossing 1 Direction	N		Crossing 2 Direction	W
	Marked Crosswalk 1 Width (in)	N/A		Marked Crosswalk 2 Width (in)	N/A
N/A	Ramp Inside Crosswalk 1	N/A	Yes	Ramp Inside Crosswalk 2	N/A
	Crossing 1 Slope (%)	0.3		Crossing 2 Slope (%)	6.9
	Crossing 1 Cross Slope (%)	1.4		Crossing 2 Cross Slope (%)	0.6
Yes	Gutter Ponding	No	Yes	Curb Slope	1.7
Yes	Gutter Lip Height (in)	0		Road Run Slope (%)	0.8
Yes	Gutter Run Slope (%)	1.2		Road Cross Slope (%)	0.9
No	Gutter Cross Slope (%)	3.1			
Yes	Overall Surface Condition: Acceptable		Yes	Perp Joint Present	Yes
	Cross Gutter Present?	Yes		Spandrel Present?	Yes
	Replace Cross Gutter?	No		Replace Spandrel?	No

