




Access Compliance Report Public Rights-of-Way (Curb Ramps)

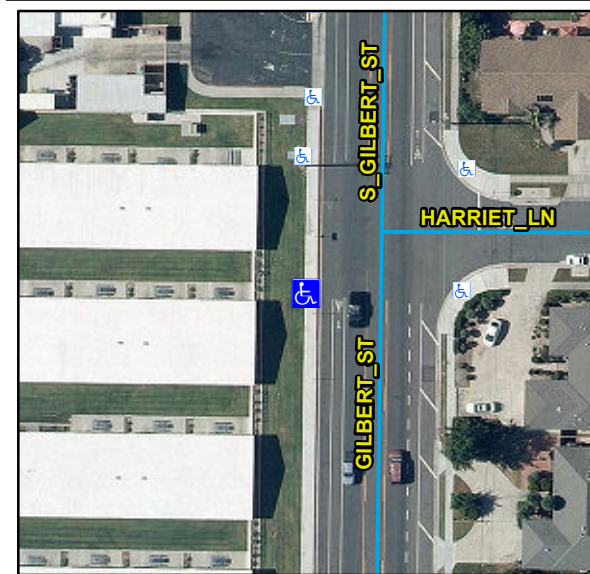

Main Street: GILBERT_ST		Cross Street: GILBERT_ST		Location:	E
ADA ID: RPRK210923125150	Ramp Type: No Ramp	Initial Pass/Fail: N/A	Overall Compliance: No	Severity Score:	100
Codes/Mitigation Info/Possible Solution			Field Measurements/Component Compliance		



Possible Solutions:

Provide Curb Ramp

Surveyor Notes:

N/A

OC Std/PROW:

STD 1115

Total Cost:

\$ 3080

Parcel ID Number

127-420-01

Ramp Island Or Median

N/A

Ramp Orientation

N/A

Google Street View Link:

http://www.google.com/maps/@?api=1&map_action=pano&viewpoint=33.81177981,-117.96772616

Street 1 Name

GILBERT_ST

Stop Condition-Street 1

N/A

Street 2 Name

GILBERT_ST

Stop Condition-Street 2

N/A

Compliance	Description	Data	Compliance	Description	Data
------------	-------------	------	------------	-------------	------

