




Access Compliance Report Public Rights-of-Way (Curb Ramps)



Main Street: **ORANGE_AVE** Cross Street: **GILBERT_ST** Location: **NW**

ADA ID: **RPRK210927110852** Ramp Type: **Type 1 - Perpendicular Diagonal Initial Pass/Fail: Pass** Overall Compliance: **No** Severity Score: **0**

Codes/Mitigation Info/Possible Solution **Field Measurements/Component Compliance**

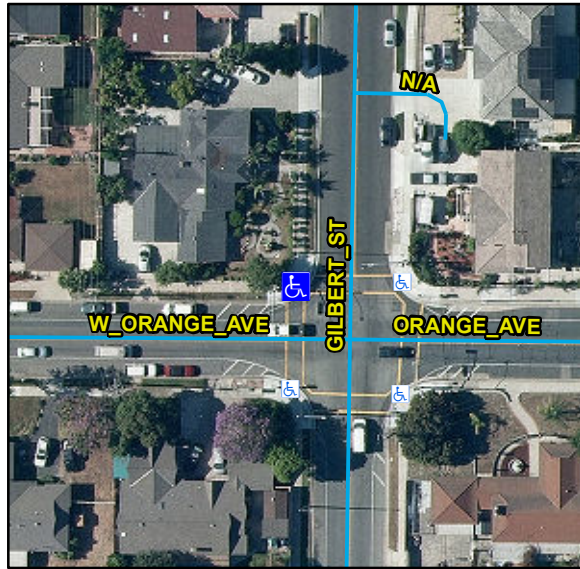

Possible Solutions:
Remove & Replace Landing. Gutter Ponding Observed.

Surveyor Notes:
N/A

OC Std/PROW:
R304.2.1, R302.7, STD 1115

Total Cost: **\$ 783**

Parcel ID Number: **127-133-20**
 Ramp Island Or Median: **None**
 Ramp Orientation: **Diag**
 Google Street View Link:
http://www.google.com/maps/@?api=1&map_action=pano&viewpoint=33.8250589,-117.96772797

Street 1 Name: **ORANGE_AVE**
 Stop Condition-Street 1: **Signal**
 Street 2 Name: **GILBERT_ST**
 Stop Condition-Street 2: **Signal**

Compliance	Description	Data	Compliance	Description	Data
N/A	Ramp Length (in)	109	N/A	Flare Type LT	
Yes	Ramp Width (in)	50			Sloped
Yes	Ramp Run Slope (%)	5.1	N/A	Flare Slope LT (%)	3.9
Yes	Ramp Cross Slope (%)	0	N/A	Flare Traversable LT	No
N/A	Landing Present	Yes	N/A	Flare Type RT	
N/A	Landing Length (in)	53			Sloped
Yes	Landing Width (in)	50	N/A	Flare Slope RT (%)	9
Yes	Landing Run Slope (%)	1.9	N/A	Flare Traversable RT	No
Yes	Landing Cross Slope (%)	0.6	Yes	DWS Provided	Yes
N/A	Landing Movement Obstructed?	Yes	Yes	DWS Contrast	Yes
	Landing Movement Type	Curb	Yes	DWS Length (in)	37
N/A	Landing Shared	No	Yes	DWS Full Width	Yes
N/A	Clear Space	Yes	Yes	DWS Offset Left (in)	0
N/A	Clear Space To Crosswalk (in)	48	Yes	DWS Offset Right (in)	N/A
N/A	Marked Crosswalk 1	No	N/A	Marked Crosswalk 2	No
	Crossing 1 Direction	S		Crossing 2 Direction	E
	Marked Crosswalk 1 Width (in)	N/A		Marked Crosswalk 2 Width (in)	N/A
N/A	Ramp Inside Crosswalk 1	N/A	Yes	Ramp Inside Crosswalk 2	N/A
	Crossing 1 Slope (%)	1.8		Crossing 2 Slope (%)	3.3
	Crossing 1 Cross Slope (%)	10.1		Crossing 2 Cross Slope (%)	0.8
No	Gutter Ponding	Yes	Yes	Curb Slope	4.9
Yes	Gutter Lip Height (in)	0		Road Run Slope (%)	1.5
Yes	Gutter Run Slope (%)	1.7		Road Cross Slope (%)	3.7
Yes	Gutter Cross Slope (%)	1.3			
Yes	Overall Surface Condition: Acceptable		Yes	Perp Joint Present	Yes
	Cross Gutter Present?	No		Spandrel Present?	No
	Replace Cross Gutter?	N/A		Replace Spandrel?	N/A

Obstruction and Utility Measurement/Component Compliance

Compliance	Description	Data	Compliance	Description	Data
Yes	Obstructions Present?	No	N/A	Utilities Present?	No
	Obstruction Types	N/A		Utility Types	
	Obstruction Dimensions	N/A			N/A

