


Access Compliance Report Public Rights-of-Way (Curb Ramps)



Main Street: MADISON AVE Cross Street: VAN_BUREN_ST NW Location: Ramp Type:Type 1 - Perpendicular Diagonal Initial Pass/Fail: Fail ADA ID: RPRK211001193219 **Overall Compliance: No Severity Score:** 20

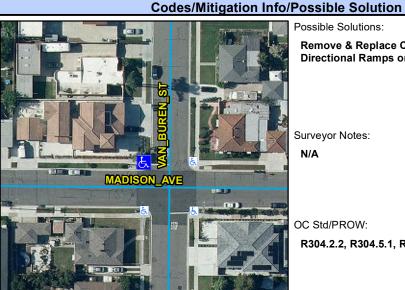

Possible Solutions:

Remove & Replace Curb Ramp With Two New Directional Ramps or Equivalent.

Surveyor Notes:

N/A

OC Std/PROW:

R304.2.2, R304.5.1, R304.5.3, STD 1115

Total Cost: 6160

Parcel ID Number 097-113-11 Street 1 Name MADISON AVE Stop Condition-Street 1 Ramp Island Or Median None **NoControl** Ramp Orientation Diag Street 2 Name VAN_BUREN_ST Google Street View Link: Stop Condition-Street 2 StopSign

http://www.google.com/maps/@?api=1&map_action=pano&viewpoint=33.74845205,-117.98648204

Obstruction and Utility Measurement/Component Compliance

Compliance Description Data		Compliance Description	Data	
Yes	Obstructions Present?	No	N/A Utilities Present?	No
	Obstruction Types	N/A	Utility Types	
	Obstruction Dimensions	N/A		N/A



Field Measurements/Component Compliance										
	Compliance Description		Data	Com	Data					
	N/A	Ramp Length (in)	104	N/A	Flare Ty	pe LT				
	No	Ramp Width (in)	36				N/A			
	No	Ramp Run Slope (%)	11.5	N/A	Flare Slo	ppe LT (%)	N/A			
	No	Ramp Cross Slope (%)	2.7	N/A	Flare Tra	aversable LT	N/A			
	N/A	Landing Present	N/A	N/A	Flare Ty	pe RT				
	N/A	Landing Length (in)	N/A				N/A			
	N/A	Landing Width (in)	N/A	N/A	Flare Slo	ope RT (%)	N/A			
	N/A	Landing Run Slope (%)	N/A	N/A	Flare Tra	aversable RT	N/A			
	N/A	Landing Cross Slope (%)	N/A	N/A	DWS Pr	ovided	N/A			
	N/A	Landing Movement Obstructed?	N/A	N/A	DWS Co	ontrast	N/A			
		Landing Movement Type	N/A	N/A	DWS Le	ngth (in)	N/A			
	N/A	Landing Shared	N/A	N/A	DWS Fu	ll Width	N/A			
	N/A	Clear Space	Yes	N/A	DWS Of	fset Left (in)	N/A			
	N/A	Clear Space To Crosswalk (in)	N/A	N/A	DWS Of	fset Right (in)	N/A			
0	N/A	Marked Crosswalk 1	No	N/A	Marked	Crosswalk 2	No			
		Crossing 1 Direction	S		Crossing	g 2 Direction	E			
Έ		Marked Crosswalk 1 Width (in)	N/A		Marked	Crosswalk 2 Width (in)	N/A			
ol	N/A	Ramp Inside Crosswalk 1	N/A	Yes	Ramp In	side Crosswalk 2	N/A			
Т		Crossing 1 Slope (%)	8.6		Crossing	g 2 Slope (%)	2.2			
ın		Crossing 1 Cross Slope (%)	0.7		Crossing	g 2 Cross Slope (%)	1.6			
	N/A	Gutter Ponding	N/A	No	Curb Slo	ope	9.1			
	Yes	Gutter Lip Height (in)	0		Road R	un Slope (%)	0.6			
	N/A	Gutter Run Slope (%)	N/A		Road Cr	oss Slope (%)	1.9			
ta	N/A	Gutter Cross Slope (%)	N/A							
lo	Yes	Overall Surface Condition: Accep	otable	Yes	Perp Jo	int Present	Yes			
Ά		Cross Gutter Present?	No		Spandre	l Present?	Yes			
A		Replace Cross Gutter?	N/A		Replace	Spandrel?	No			