



Access Compliance Report Public Rights-of-Way (Curb Ramps)




Main Street: STRATTON_WAY Cross Street: 17TH_ST Location: SW

ADA ID: RPRK211007123727 Ramp Type: Type 7 - Directional 2 Initial Pass/Fail: Pass Overall Compliance: No Severity Score: 5

Codes/Mitigation Info/Possible Solution

Field Measurements/Component Compliance

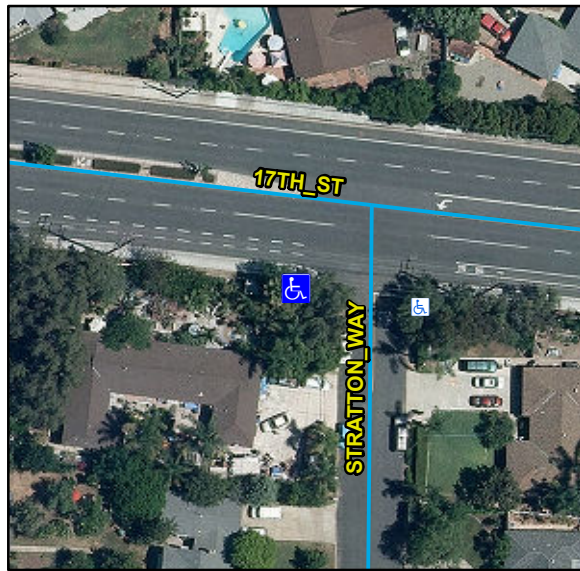

Possible Solutions:

Remove & Replace Entire Ramp. Remove & Replace Gutter.

Surveyor Notes:

N/A

OC Std/PROW:

R304.2.2, R304.2.2-Perp, R304.3.2-Para, R304.5.3, R305.2, R302.7, STD 1115

Total Cost: \$ 3332

Parcel ID Number 401-073-01
Ramp Island Or Median None
Ramp Orientation NonDiag
Google Street View Link:

Street 1 Name STRATTON_WAY
Stop Condition-Street 1 StopSign
Street 2 Name 17TH_ST
Stop Condition-Street 2 N/A

http://www.google.com/maps/@?api=1&map_action=pano&viewpoint=33.75946802,-117.80963003

Obstruction and Utility Measurement/Component Compliance

Compliance	Description	Data	Compliance	Description	Data
Yes	Obstructions Present?	No	N/A	Utilities Present?	No
	Obstruction Types	N/A		Utility Types	
	Obstruction Dimensions	N/A			N/A

Compliance	Description	Data	Compliance	Description	Data
N/A	Ramp Length (in)	160	Yes	Flare Type LT	
Yes	Ramp Width (in)	50			Curbed2
Yes	Ramp Run Slope (%)	3.8	N/A	Flare Slope LT (%)	N/A
Yes	Ramp Cross Slope (%)	1.9	N/A	Flare Traversable LT	N/A
Yes	Grade Break	Yes	N/A	Flare Type RT	
No	Grade Break Slope (%)	6.2			None
Yes	Grade Break Cross Slope (%)	0.6	N/A	Flare Slope RT (%)	N/A
	Addl Para Ramp Left?	No	N/A	Flare Traversable RT	N/A
	Addl Para Ramp Right?	No	Yes	DWS Provided	Yes
N/A	Landing Present	Yes	Yes	DWS Contrast	Yes
Yes	Landing Length (in)	112	Yes	DWS Length (in)	36
Yes	Landing Width (in)	52	Yes	DWS Full Width	Yes
No	Landing Run Slope (%)	5.5		DWS Offset Type	Multiple
Yes	Landing Cross Slope (%)	0	No	DWS Left Offset (in)	101
N/A	Landing Movement Obstructed?	Yes	Yes	DWS Right Offset (in)	0
	Landing Movement Type	SS			
N/A	Landing Shared	No			
N/A	Marked Crosswalk 1	No	N/A	Clear Space	N/A
	Crossing 1 Direction	E	N/A	Clear Space To Crosswalk (in)	N/A
	Marked Crosswalk 1 Width (in)	N/A			
N/A	Ramp Inside Crosswalk 1	N/A			
	Crossing 1 Slope (%)	0.1			
	Crossing 1 Cross Slope (%)	4.2			
No	Gutter Ponding	Yes	No	Curb Slope	8.7
Yes	Gutter Lip Height (in)	0		Road Run Slope (%)	N/A
Yes	Gutter Run Slope (%)	1		Road Cross Slope (%)	N/A
No	Gutter Cross Slope (%)	6.2		Parallel Ramp Side	Left
Yes	Overall Surface Condition	Acceptable	Yes	Perp Joint Present	Yes
	Cross Gutter Present?	No		Spandrel Present?	No
	Replace Cross Gutter?	N/A		Replace Spandrel?	N/A

