



Access Compliance Report Public Rights-of-Way (Curb Ramps)




Main Street: 17TH_ST Cross Street: HOLT_AVE Location: S

ADA ID: RPRK211007145234 Ramp Type: Type 4 - Parallel Initial Pass/Fail: Fail Overall Compliance: No Severity Score: 32

Codes/Mitigation Info/Possible Solution

Field Measurements/Component Compliance

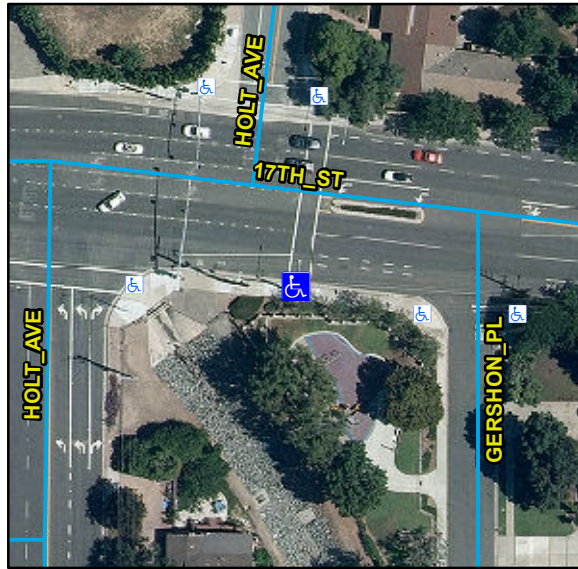

Possible Solutions:

Remove & Replace Entire Ramp. Restripe Crosswalk.

Surveyor Notes:

N/A

OC Std/PROW:

R304.5.3, R304.3.2, R302.3, R402.2, STD 1115

Total Cost: \$ 6000

Parcel ID Number 401-052-12
Ramp Island Or Median None
Ramp Orientation NonDiag
Google Street View Link:

http://www.google.com/maps/@?api=1&map_action=pano&viewpoint=33.75982108,-117.81392177

Street 1 Name 17TH_ST
Stop Condition-Street 1 Signal
Street 2 Name HOLT_AVE
Stop Condition-Street 2 N/A

Obstruction and Utility Measurement/Component Compliance

Compliance	Description	Data	Compliance	Description	Data
No	Obstructions Present?	Yes	N/A	Utilities Present?	No
	Obstruction Types	Traffic Signal Pole		Utility Types	
	Obstruction Dimensions	N/A			N/A

Compliance	Description	Data	Compliance	Description	Data
N/A	Ramp Length LT (in)	99	N/A	Ramp Length RT (in)	98
Yes	Ramp Width LT (in)	96	Yes	Ramp Width RT (in)	96
Yes	Ramp Run Slope LT (%)	4.4	No	Ramp Run Slope RT (%)	12.1
No	Ramp Cross Slope LT (%)	3.4	Yes	Ramp Cross Slope RT (%)	0.5
N/A	Landing Present	N/A	N/A	DWS Provided	N/A
N/A	Landing Length (in)	N/A	N/A	DWS Contrast	N/A
N/A	Landing Width (in)	N/A	N/A	DWS Length (in)	N/A
N/A	Landing Run Slope (%)	N/A	N/A	DWS Full Width	N/A
N/A	Landing Cross Slope (%)	N/A		DWS Offset Type	N/A
N/A	Landing Movement Obstructed?	N/A	N/A	DWS Offset Left (in)	N/A
	Landing Movement Type	N/A	N/A	DWS Offset Right (in)	N/A
N/A	Landing Shared	N/A			
N/A	Clear Space	N/A			
N/A	Clear Space To Crosswalk (in)	N/A			
N/A	Marked Crosswalk 1	Yes	N/A	Marked Crosswalk 2	N/A
	Crossing 1 Direction	N		Crossing 2 Direction	N/A
	Marked Crosswalk 1 Width (in)	120		Marked Crosswalk 2 Width (in)	N/A
N/A	Ramp Inside Crosswalk 1	No	N/A	Ramp Inside Crosswalk 2	N/A
	Crossing 1 Slope (%)	9.3		Crossing 2 Slope (%)	N/A
	Crossing 1 Cross Slope (%)	1.6		Crossing 2 Cross Slope (%)	N/A
N/A	Gutter Ponding	N/A	N/A	Curb Slope	12
Yes	Gutter Lip Height (in)	0		Road Run Slope (%)	N/A
N/A	Gutter Run Slope (%)	N/A		Road Cross Slope (%)	N/A
N/A	Gutter Cross Slope (%)	N/A	Yes	Perpendicular Joint Present	Yes
Yes	Overall Surface Condition	Acceptable			
	Cross Gutter Present?	No		Spandrel Present?	No
	Replace Cross Gutter?	N/A		Replace Spandrel?	N/A

