




Access Compliance Report Public Rights-of-Way (Curb Ramps)

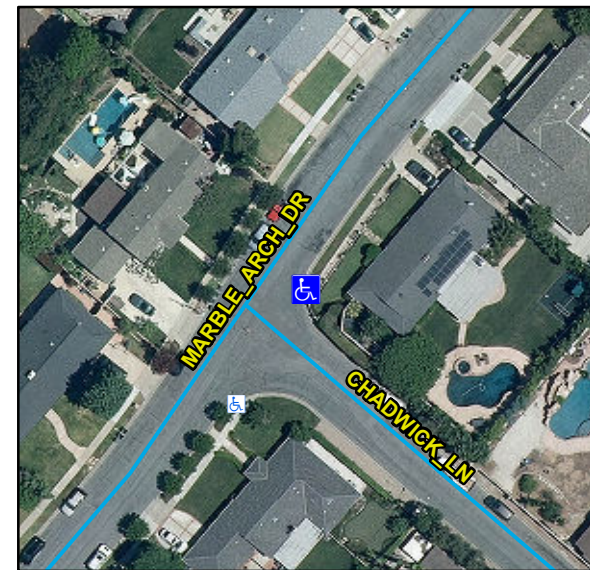

Main Street: CHADWICK_LN		Cross Street: MARBLE_ARCH_DR		Location:	E
ADA ID: RPRK211012131257	Ramp Type: Type 6 - Directional 1	Initial Pass/Fail: Pass	Overall Compliance: No	Severity Score:	19
Codes/Mitigation Info/Possible Solution			Field Measurements/Component Compliance		



Possible Solutions:

Remove & Replace Entire Ramp. Remove & Replace Gutter.

Surveyor Notes:

N/A

OC Std/PROW:

R304.2.1, R304.5.2, R305, R304.5.4, STD 1115


Total Cost: \$ 3332

Parcel ID Number	502-142-19	Street 1 Name	CHADWICK_LN
Ramp Island Or Median	None	Stop Condition-Street 1	NoControl
Ramp Orientation	NonDiag	Street 2 Name	MARBLE_ARCH_DR
Google Street View Link:		Stop Condition-Street 2	N/A

http://www.google.com/maps/@?api=1&map_action=pano&viewpoint=33.76011113,-117.79602657

Obstruction and Utility Measurement/Component Compliance

Compliance	Description	Data	Compliance	Description	Data
Yes	Obstructions Present?	No	N/A	Utilities Present?	No
	Obstruction Types	N/A		Utility Types	
	Obstruction Dimensions	N/A			N/A

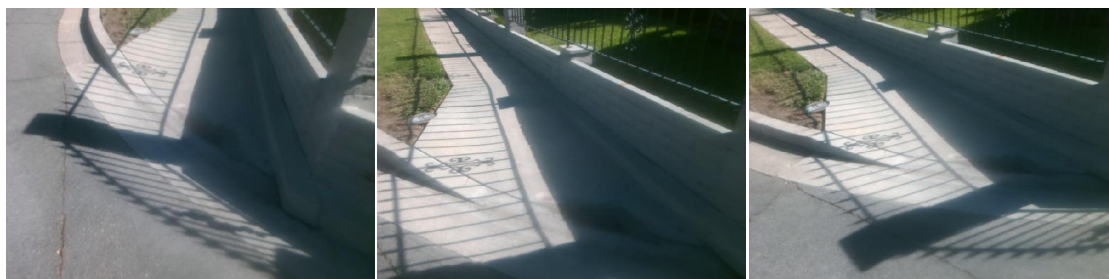

Compliance	Description	Data	Compliance	Description	Data
N/A	Ramp Length (in)	122	N/A	Flare Type LT	
Yes	Ramp Width (in)	60			Sloped
Yes	Ramp Run Slope (%)	8.1	N/A	Flare Slope LT (%)	15.1
Yes	Ramp Cross Slope (%)	3.1	N/A	Flare Traversable LT	No
No	Grade Break	No	Yes	Flare Type RT	
N/A	Grade Break Slope (%)	N/A			Curbed2
N/A	Grade Break Cross Slope (%)	N/A	N/A	Flare Slope RT (%)	N/A
	Addl Para Ramp Left?	No	N/A	Flare Traversable RT	N/A
	Addl Para Ramp Right?	No	No	DWS Provided	No
N/A	Landing Present	Yes	N/A	DWS Contrast	N/A
Yes	Landing Length (in)	70	N/A	DWS Length (in)	N/A
No	Landing Width (in)	46	N/A	DWS Full Width	N/A
Yes	Landing Run Slope (%)	1.7		DWS Offset Type	N/A
Yes	Landing Cross Slope (%)	0.8	N/A	DWS Left Offset (in)	N/A
N/A	Landing Movement Obstructed?	No	N/A	DWS Right Offset (in)	N/A
	Landing Movement Type	N/A			
N/A	Landing Shared	No			
N/A	Marked Crosswalk 1	No	N/A	Clear Space	N/A
	Crossing 1 Direction	SW	N/A	Clear Space To Crosswalk (in)	N/A
	Marked Crosswalk 1 Width (in)	N/A			
N/A	Ramp Inside Crosswalk 1	N/A			
	Crossing 1 Slope (%)	7.2			
	Crossing 1 Cross Slope (%)	4.1			
Yes	Gutter Ponding	No	Yes	Curb Slope	4.8
Yes	Gutter Lip Height (in)	0		Road Run Slope (%)	N/A
No	Gutter Run Slope (%)	8.8		Road Cross Slope (%)	N/A
Yes	Gutter Cross Slope (%)	1.7		Parallel Ramp Side	Left
Yes	Overall Surface Condition	Acceptable	Yes	Perp Joint Present	Yes
	Cross Gutter Present?	No		Spandrel Present?	No
	Replace Cross Gutter?	N/A		Replace Spandrel?	N/A