




Access Compliance Report Public Rights-of-Way (Curb Ramps)

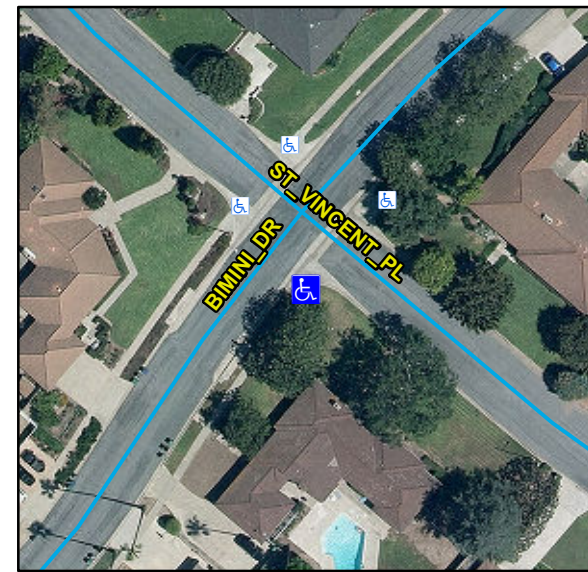

Main Street: ST_VINCENT_PL		Cross Street: BIMINI_DR		Location:	S
ADA ID: RPRK211013144310	Ramp Type: Type 6 - Directional 1	Initial Pass/Fail: Pass	Overall Compliance: No	Severity Score:	14
Codes/Mitigation Info/Possible Solution			Field Measurements/Component Compliance		



Possible Solutions:

Remove & Replace Entire Ramp.

Surveyor Notes:

N/A

OC Std/PROW:

R304.2.1, R305, STD 1115

Total Cost: \$ 3080


Parcel ID Number 502-262-09
Ramp Island Or Median None
Ramp Orientation NonDiag
Google Street View Link:

http://www.google.com/maps/@?api=1&map_action=pano&viewpoint=33.76726642,-117.79127596

Street 1 Name ST_VINCENT_PL
Stop Condition-Street 1 NoControl
Street 2 Name BIMINI_DR
Stop Condition-Street 2 N/A

Obstruction and Utility Measurement/Component Compliance

Compliance	Description	Data	Compliance	Description	Data
Yes	Obstructions Present?	No	N/A	Utilities Present?	No
	Obstruction Types	N/A		Utility Types	
	Obstruction Dimensions	N/A			N/A

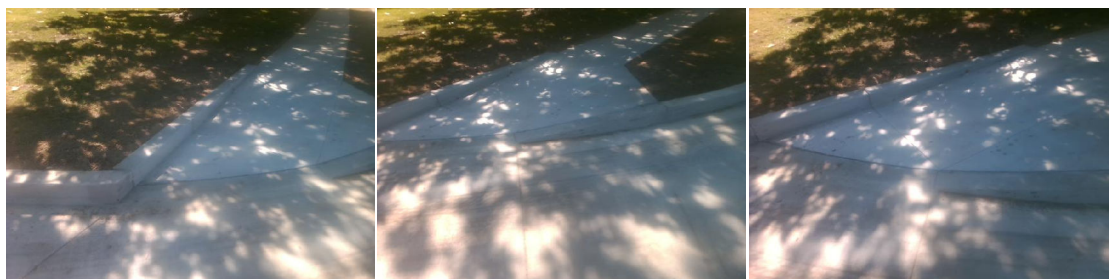

Compliance	Description	Data	Compliance	Description	Data
N/A	Ramp Length (in)	126	Yes	Flare Type LT	Curbed2
Yes	Ramp Width (in)	85			
Yes	Ramp Run Slope (%)	2.1	N/A	Flare Slope LT (%)	N/A
Yes	Ramp Cross Slope (%)	0.1	N/A	Flare Traversable LT	N/A
Yes	Grade Break	Yes	N/A	Flare Type RT	
Yes	Grade Break Slope (%)	3.2			Sloped
Yes	Grade Break Cross Slope (%)	0.9	N/A	Flare Slope RT (%)	3.4
	Addl Para Ramp Left?	No	N/A	Flare Traversable RT	No
	Addl Para Ramp Right?	No	No	DWS Provided	No
N/A	Landing Present	Yes	N/A	DWS Contrast	N/A
No	Landing Length (in)	45	N/A	DWS Length (in)	N/A
Yes	Landing Width (in)	48	N/A	DWS Full Width	N/A
Yes	Landing Run Slope (%)	1.5		DWS Offset Type	N/A
Yes	Landing Cross Slope (%)	0.2	N/A	DWS Left Offset (in)	N/A
N/A	Landing Movement Obstructed?	No	N/A	DWS Right Offset (in)	N/A
	Landing Movement Type	N/A			
N/A	Landing Shared	No			
N/A	Marked Crosswalk 1	No	N/A	Clear Space	N/A
	Crossing 1 Direction	NE	N/A	Clear Space To Crosswalk (in)	N/A
	Marked Crosswalk 1 Width (in)	N/A			
N/A	Ramp Inside Crosswalk 1	N/A			
	Crossing 1 Slope (%)	2.9			
	Crossing 1 Cross Slope (%)	3.8			
Yes	Gutter Ponding	No	Yes	Curb Slope	2
Yes	Gutter Lip Height (in)	0		Road Run Slope (%)	N/A
Yes	Gutter Run Slope (%)	1.2		Road Cross Slope (%)	N/A
Yes	Gutter Cross Slope (%)	1.6		Parallel Ramp Side	Left
Yes	Overall Surface Condition	Acceptable	Yes	Perp Joint Present	Yes
	Cross Gutter Present?	Yes		Spandrel Present?	Yes
	Replace Cross Gutter?	No		Replace Spandrel?	No