



Access Compliance Report Public Rights-of-Way (Curb Ramps)




Main Street: **FOOTHILL_BLV** Cross Street: **ORANGE_KNOLL_DR** Location: **S**

ADA ID: **RPRK211013172329** Ramp Type: **Type 4 - Parallel** Initial Pass/Fail: **Pass** Overall Compliance: **No** Severity Score: **5**

Codes/Mitigation Info/Possible Solution

Field Measurements/Component Compliance

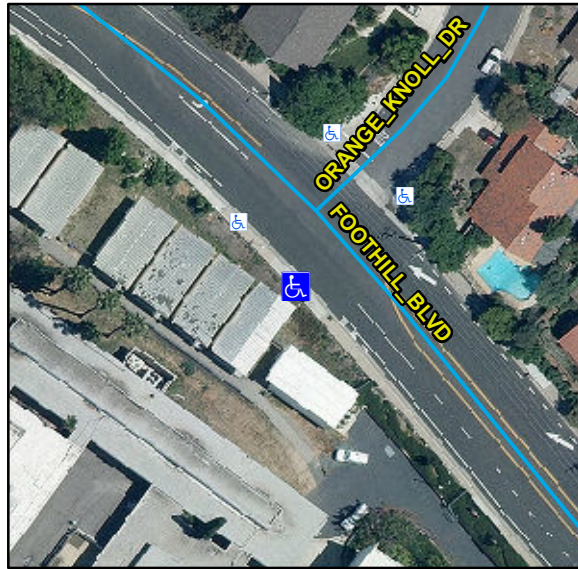

Possible Solutions:

**Remove & Replace Detectable Warning System.
Gutter Ponding Observed.**

Surveyor Notes:

N/A

OC Std/PROW:

R305.1.3, R302.7, STD 1115

Total Cost: \$ **1052**

Parcel ID Number **395-521-01**
Ramp Island Or Median **None**
Ramp Orientation **NonDiag**
Google Street View Link:

http://www.google.com/maps/@?api=1&map_action=pano&viewpoint=33.76803222,-117.79660073

Street 1 Name **FOOTHILL_BLV**
Stop Condition-Street 1 **NoControl**
Street 2 Name **ORANGE_KNOLL_DR**
Stop Condition-Street 2 **N/A**

Obstruction and Utility Measurement/Component Compliance

Compliance	Description	Data	Compliance	Description	Data
Yes	Obstructions Present?	No	N/A	Utilities Present?	No
	Obstruction Types	N/A		Utility Types	
	Obstruction Dimensions	N/A			N/A

Compliance	Description	Data	Compliance	Description	Data
N/A	Ramp Length LT (in)	106	N/A	Ramp Length RT (in)	117
Yes	Ramp Width LT (in)	53	Yes	Ramp Width RT (in)	52
Yes	Ramp Run Slope LT (%)	3.9	Yes	Ramp Run Slope RT (%)	4.2
Yes	Ramp Cross Slope LT (%)	1.1	Yes	Ramp Cross Slope RT (%)	0.5
N/A	Landing Present	Yes	Yes	DWS Provided	Yes
N/A	Landing Length (in)	52	No	DWS Contrast	No
Yes	Landing Width (in)	48	Yes	DWS Length (in)	36
Yes	Landing Run Slope (%)	1.1	Yes	DWS Full Width	Yes
Yes	Landing Cross Slope (%)	0.5		DWS Offset Type	Single
N/A	Landing Movement Obstructed?	No	Yes	DWS Offset Left (in)	0
	Landing Movement Type	Curb	Yes	DWS Offset Right (in)	N/A
N/A	Landing Shared	No			
N/A	Clear Space	N/A			
N/A	Clear Space To Crosswalk (in)	N/A			
N/A	Marked Crosswalk 1	No	N/A	Marked Crosswalk 2	N/A
	Crossing 1 Direction	NE		Crossing 2 Direction	N/A
	Marked Crosswalk 1 Width (in)	N/A		Marked Crosswalk 2 Width (in)	N/A
N/A	Ramp Inside Crosswalk 1	N/A	N/A	Ramp Inside Crosswalk 2	N/A
	Crossing 1 Slope (%)	3.9		Crossing 2 Slope (%)	N/A
	Crossing 1 Cross Slope (%)	0.2		Crossing 2 Cross Slope (%)	N/A
No	Gutter Ponding	Yes	Yes	Curb Slope	4.6
Yes	Gutter Lip Height (in)	0		Road Run Slope (%)	N/A
Yes	Gutter Run Slope (%)	2		Road Cross Slope (%)	N/A
Yes	Gutter Cross Slope (%)	0.5	Yes	Perpendicular Joint Present	Yes
Yes	Overall Surface Condition	Acceptable			
	Cross Gutter Present?	No		Spandrel Present?	No
	Replace Cross Gutter?	N/A		Replace Spandrel?	N/A

