



Access Compliance Report Public Rights-of-Way (Curb Ramps)




Main Street: **BROWNING_AVE** Cross Street: **LA_COLINA_DR** Location: **SE**

ADA ID: **RPRK211014133803** Ramp Type: **Type 4 - Parallel** Initial Pass/Fail: **Fail** Overall Compliance: **No** Severity Score: **15**

Codes/Mitigation Info/Possible Solution

Field Measurements/Component Compliance

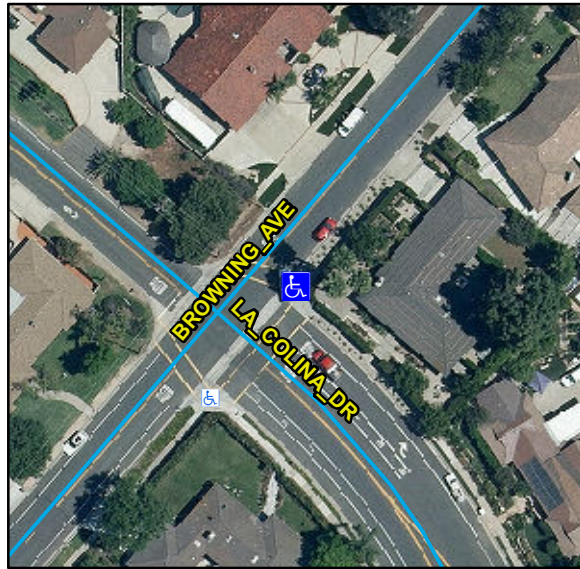

Possible Solutions:

Remove & Replace Curb Ramp With Two New Directional Ramps or Equivalent.

Surveyor Notes:

N/A

OC Std/PROW:

R304.3.2, STD 1115

Total Cost: \$ **4000**

Parcel ID Number **104-332-11**
Ramp Island Or Median **None**
Ramp Orientation **Diag**
Google Street View Link:

http://www.google.com/maps/@?api=1&map_action=pano&viewpoint=33.74566835,-117.79190954

Street 1 Name **BROWNING_AVE**
Stop Condition-Street 1 **StopSign**
Street 2 Name **LA_COLINA_DR**
Stop Condition-Street 2 **StopSign**

Obstruction and Utility Measurement/Component Compliance

Compliance	Description	Data	Compliance	Description	Data
Yes	Obstructions Present?	No	N/A	Utilities Present?	No
	Obstruction Types	N/A		Utility Types	
	Obstruction Dimensions	N/A			N/A

Compliance	Description	Data	Compliance	Description	Data
N/A	Ramp Length LT (in)	98	N/A	Ramp Length RT (in)	123
Yes	Ramp Width LT (in)	78	Yes	Ramp Width RT (in)	52
No	Ramp Run Slope LT (%)	8.4	Yes	Ramp Run Slope RT (%)	8.3
Yes	Ramp Cross Slope LT (%)	1.1	Yes	Ramp Cross Slope RT (%)	1.3
N/A	Landing Present	N/A	N/A	DWS Provided	N/A
N/A	Landing Length (in)	N/A	N/A	DWS Contrast	N/A
N/A	Landing Width (in)	N/A	N/A	DWS Length (in)	N/A
N/A	Landing Run Slope (%)	N/A	N/A	DWS Full Width	N/A
N/A	Landing Cross Slope (%)	N/A		DWS Offset Type	N/A
N/A	Landing Movement Obstructed?	N/A	N/A	DWS Offset Left (in)	N/A
	Landing Movement Type	N/A	N/A	DWS Offset Right (in)	N/A
N/A	Landing Shared	N/A			
N/A	Clear Space	Yes			
N/A	Clear Space To Crosswalk (in)	48			
N/A	Marked Crosswalk 1	Yes	N/A	Marked Crosswalk 2	Yes
	Crossing 1 Direction	NW		Crossing 2 Direction	SW
	Marked Crosswalk 1 Width (in)	144		Marked Crosswalk 2 Width (in)	144
N/A	Ramp Inside Crosswalk 1	Yes	N/A	Ramp Inside Crosswalk 2	Yes
	Crossing 1 Slope (%)	11.8		Crossing 2 Slope (%)	0.6
	Crossing 1 Cross Slope (%)	1.5		Crossing 2 Cross Slope (%)	1.3
N/A	Gutter Ponding	N/A	N/A	Curb Slope	8.7
Yes	Gutter Lip Height (in)	0		Road Run Slope (%)	3
N/A	Gutter Run Slope (%)	N/A		Road Cross Slope (%)	1.4
N/A	Gutter Cross Slope (%)	N/A	Yes	Perpendicular Joint Present	Yes
Yes	Overall Surface Condition	Acceptable			
	Cross Gutter Present?	Yes		Spandrel Present?	Yes
	Replace Cross Gutter?	No		Replace Spandrel?	No

