




Access Compliance Report Public Rights-of-Way (Curb Ramps)

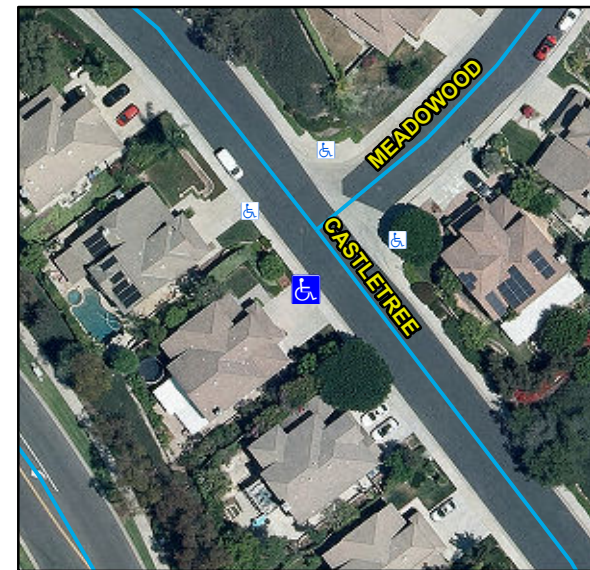

Main Street: CASTLETREE		Cross Street: CASTLETREE		Location:	S
ADA ID: RPRK211018151137	Ramp Type: No Ramp	Initial Pass/Fail: N/A	Overall Compliance: No	Severity Score:	100
Codes/Mitigation Info/Possible Solution			Field Measurements/Component Compliance		



Possible Solutions:
Provide Curb Ramp

Surveyor Notes:
N/A

OC Std/PROW:
STD 1115

Total Cost: \$ 3080

Compliance	Description	Data	Compliance	Description	Data

Parcel ID Number	780-063-03	Street 1 Name	CASTLETREE
Ramp Island Or Median	N/A	Stop Condition-Street 1	N/A
Ramp Orientation	N/A	Street 2 Name	CASTLETREE
Google Street View Link:		Stop Condition-Street 2	N/A

http://www.google.com/maps/@?api=1&map_action=pano&viewpoint=33.59449982,-117.62228707

