




Access Compliance Report Public Rights-of-Way (Curb Ramps)



Main Street: CHAPARRAL_CT **Cross Street:** CRESTVIEW **Location:** NE

ADA ID: RPRK211018175449 **Ramp Type:** Type 1 - Perpendicular Diagonal Initial Pass/Fail: Fail **Overall Compliance:** No **Severity Score:** 2

Codes/Mitigation Info/Possible Solution **Field Measurements/Component Compliance**

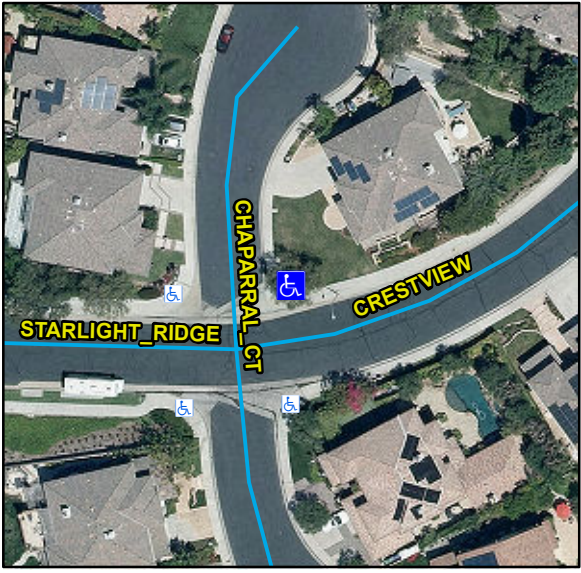

Possible Solutions:
Remove & Replace Curb Ramp With Two New Directional Ramps or Equivalent.

Surveyor Notes:
 N/A

OC Std/PROW:
 R304.2.2, R304.5.3, R302.7.2, STD 1115

Total Cost: \$ **6160**

Parcel ID Number: 780-122-07
Ramp Island Or Median: None
Ramp Orientation: Diag
Google Street View Link:
http://www.google.com/maps/@?api=1&map_action=pano&viewpoint=33.58886105,-117.6214964

Street 1 Name: CHAPARRAL_CT
Stop Condition-Street 1: NoControl
Street 2 Name: CRESTVIEW
Stop Condition-Street 2: NoControl

Compliance	Description	Data	Compliance	Description	Data
N/A	Ramp Length (in)	85	N/A	Flare Type LT	
Yes	Ramp Width (in)	48			N/A
Yes	Ramp Run Slope (%)	3.4	N/A	Flare Slope LT (%)	N/A
No	Ramp Cross Slope (%)	4.9	N/A	Flare Traversable LT	N/A
N/A	Landing Present	N/A	N/A	Flare Type RT	
N/A	Landing Length (in)	N/A			N/A
N/A	Landing Width (in)	N/A	N/A	Flare Slope RT (%)	N/A
N/A	Landing Run Slope (%)	N/A	N/A	Flare Traversable RT	N/A
N/A	Landing Cross Slope (%)	N/A	N/A	DWS Provided	N/A
N/A	Landing Movement Obstructed?	N/A	N/A	DWS Contrast	N/A
	Landing Movement Type	N/A	N/A	DWS Length (in)	N/A
N/A	Landing Shared	N/A	N/A	DWS Full Width	N/A
N/A	Clear Space	Yes	N/A	DWS Offset Left (in)	N/A
N/A	Clear Space To Crosswalk (in)	N/A	N/A	DWS Offset Right (in)	N/A
N/A	Marked Crosswalk 1	No	N/A	Marked Crosswalk 2	No
	Crossing 1 Direction	W		Crossing 2 Direction	S
	Marked Crosswalk 1 Width (in)	N/A		Marked Crosswalk 2 Width (in)	N/A
N/A	Ramp Inside Crosswalk 1	N/A	Yes	Ramp Inside Crosswalk 2	N/A
	Crossing 1 Slope (%)	3.7		Crossing 2 Slope (%)	2.7
	Crossing 1 Cross Slope (%)	2.8		Crossing 2 Cross Slope (%)	6.6
N/A	Gutter Ponding	N/A	No	Curb Slope	5.9
No	Gutter Lip Height (in)	0.25		Road Run Slope (%)	4.5
N/A	Gutter Run Slope (%)	N/A		Road Cross Slope (%)	5
N/A	Gutter Cross Slope (%)	N/A			
Yes	Overall Surface Condition:	Acceptable	Yes	Perp Joint Present	Yes
	Cross Gutter Present?	Yes		Spandrel Present?	Yes
	Replace Cross Gutter?	No		Replace Spandrel?	No

Obstruction and Utility Measurement/Component Compliance

Compliance	Description	Data	Compliance	Description	Data
Yes	Obstructions Present?	No	N/A	Utilities Present?	No
	Obstruction Types	N/A		Utility Types	
	Obstruction Dimensions	N/A			N/A

