




Access Compliance Report Public Rights-of-Way (Curb Ramps)

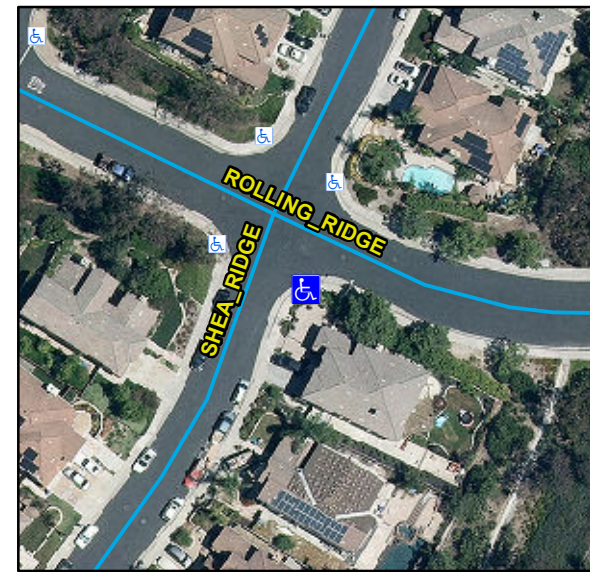

Main Street: ROLLING_RIDGE		Cross Street: SHEA_RIDGE		Location:	S
ADA ID: RPRK211019142246	Ramp Type: Type 4 - Parallel	Initial Pass/Fail: Fail	Overall Compliance: No	Severity Score:	45
Codes/Mitigation Info/Possible Solution			Field Measurements/Component Compliance		



Possible Solutions:

Remove & Replace Curb Ramp With Two New Directional Ramps or Equivalent. Grind Gutter Lip.

Surveyor Notes:

N/A

OC Std/PROW:


R204.3, R304.3.2, R304.5.3, R302.7.2, STD 1115

Total Cost: \$ 4150

Parcel ID Number	780-193-25	Street 1 Name	ROLLING_RIDGE
Ramp Island Or Median	None	Stop Condition-Street 1	NoControl
Ramp Orientation	Diag	Street 2 Name	SHEA_RIDGE
Google Street View Link:		Stop Condition-Street 2	NoControl
http://www.google.com/maps/@?api=1&map_action=pano&viewpoint=33.58233556,-117.62315091			

Obstruction and Utility Measurement/Component Compliance

Compliance	Description	Data	Compliance	Description	Data
Yes	Obstructions Present?	No	N/A	Utilities Present?	No
	Obstruction Types	N/A		Utility Types	
	Obstruction Dimensions	N/A			N/A

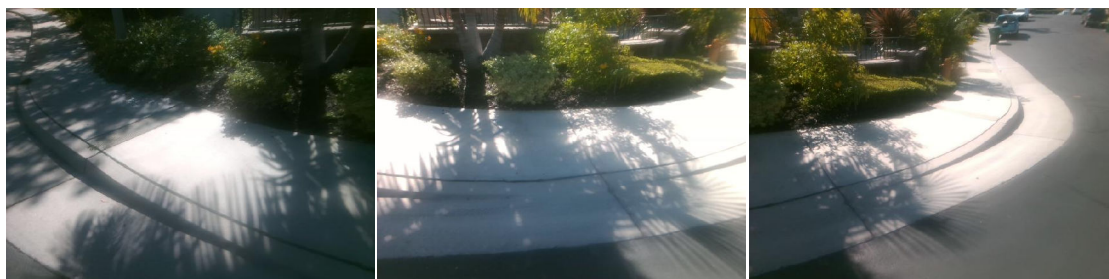

Compliance	Description	Data	Compliance	Description	Data
N/A	Ramp Length LT (in)	119	N/A	Ramp Length RT (in)	118
Yes	Ramp Width LT (in)	54	Yes	Ramp Width RT (in)	54
No	Ramp Run Slope LT (%)	9.1	No	Ramp Run Slope RT (%)	8.6
No	Ramp Cross Slope LT (%)	12.9	No	Ramp Cross Slope RT (%)	14.2
N/A	Landing Present	N/A	N/A	DWS Provided	N/A
N/A	Landing Length (in)	N/A	N/A	DWS Contrast	N/A
N/A	Landing Width (in)	N/A	N/A	DWS Length (in)	N/A
N/A	Landing Run Slope (%)	N/A	N/A	DWS Full Width	N/A
N/A	Landing Cross Slope (%)	N/A		DWS Offset Type	N/A
N/A	Landing Movement Obstructed?	N/A	N/A	DWS Offset Left (in)	N/A
	Landing Movement Type	N/A	N/A	DWS Offset Right (in)	N/A
N/A	Landing Shared	N/A			
N/A	Clear Space	Yes			
N/A	Clear Space To Crosswalk (in)	N/A			
N/A	Marked Crosswalk 1	No	N/A	Marked Crosswalk 2	No
	Crossing 1 Direction	NE		Crossing 2 Direction	NW
	Marked Crosswalk 1 Width (in)	N/A		Marked Crosswalk 2 Width (in)	N/A
N/A	Ramp Inside Crosswalk 1	N/A	N/A	Ramp Inside Crosswalk 2	N/A
	Crossing 1 Slope (%)	0.9		Crossing 2 Slope (%)	7.3
	Crossing 1 Cross Slope (%)	7.9		Crossing 2 Cross Slope (%)	1.2
N/A	Gutter Ponding	N/A	N/A	Curb Slope	7.3
No	Gutter Lip Height (in)	0.25		Road Run Slope (%)	4.6
N/A	Gutter Run Slope (%)	N/A		Road Cross Slope (%)	0.1
N/A	Gutter Cross Slope (%)	N/A	No	Perpendicular Joint Present	No
Yes	Overall Surface Condition	Acceptable			
	Cross Gutter Present?	No		Spandrel Present?	No
	Replace Cross Gutter?	N/A		Replace Spandrel?	N/A