Access Compliance Report
Public Rights-of-Way
(Curb Ramps)

Main Street: MAYBECK_LN | **Cross Street: DANBURY** | **Location: SW**

ADA ID: RPRK211025113137 | **Ramp Type: Type 4 - Parallel** | **Initial Pass/Fail: Fail** | **Overall Compliance: No** | **Severity Score: 16**

Codes/Mitigation Info/Possible Solution

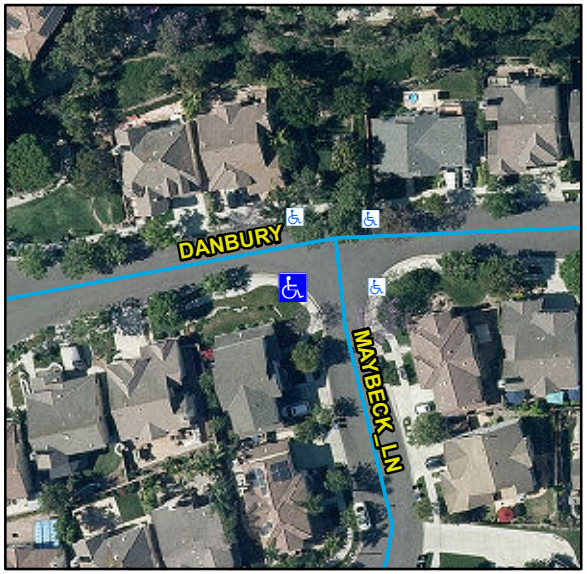

Possible Solutions:

Remove & Replace Curb Ramp With Two New Directional Ramps or Equivalent.

Surveyor Notes:

N/A

OC Std/PROW:

R204.3, R304.3.2, R304.5.3, STD 1115

Total Cost: **$ 4000**

Parcel ID Number	**759-281-08**	Street 1 Name	**MAYBECK_LN**
Ramp Island Or Median	**None**	Stop Condition-Street 1	**NoControl**
Ramp Orientation	**Diag**	Street 2 Name	**DANBURY**
Google Street View Link:		Stop Condition-Street 2	**NoControl**

http://www.google.com/maps/@?api=1&map_action=pano&viewpoint=33.56815874,-117.63938589

Obstruction and Utility Measurement/Component Compliance

Compliance	Description	Data	Compliance	Description	Data
Yes	Obstructions Present?	**No**	**N/A**	Utilities Present?	**No**
	Obstruction Types	**N/A**		Utility Types	
	Obstruction Dimensions	**N/A**			**N/A**

Field Measurements/Component Compliance

Compliance	Description	Data	Compliance	Description	Data
N/A	Ramp Length LT (in)	**116**	**N/A**	Ramp Length RT (in)	**119**
Yes	Ramp Width LT (in)	**52**	**Yes**	Ramp Width RT (in)	**52**
No	Ramp Run Slope LT (%)	**9.4**	**Yes**	Ramp Run Slope RT (%)	**1.5**
No	Ramp Cross Slope LT (%)	**2.6**	**Yes**	Ramp Cross Slope RT (%)	**1.5**
N/A	Landing Present	**N/A**	**N/A**	DWS Provided	**N/A**
N/A	Landing Length (in)	**N/A**	**N/A**	DWS Contrast	**N/A**
N/A	Landing Width (in)	**N/A**	**N/A**	DWS Length (in)	**N/A**
N/A	Landing Run Slope (%)	**N/A**	**N/A**	DWS Full Width	**N/A**
N/A	Landing Cross Slope (%)	**N/A**		DWS Offset Type	**N/A**
N/A	Landing Movement Obstructed?	**N/A**	**N/A**	DWS Offset Left (in)	**N/A**
	Landing Movement Type	**N/A**	**N/A**	DWS Offset Right (in)	**N/A**
N/A	Landing Shared	**N/A**			
N/A	Clear Space	**Yes**			
N/A	Clear Space To Crosswalk (in)	**N/A**			
N/A	Marked Crosswalk 1	**No**	**N/A**	Marked Crosswalk 2	**No**
	Crossing 1 Direction	**E**		Crossing 2 Direction	**N**
	Marked Crosswalk 1 Width (in)	**N/A**		Marked Crosswalk 2 Width (in)	**N/A**
N/A	Ramp Inside Crosswalk 1	**N/A**	**N/A**	Ramp Inside Crosswalk 2	**N/A**
	Crossing 1 Slope (%)	**3.9**		Crossing 2 Slope (%)	**1.2**
	Crossing 1 Cross Slope (%)	**1.9**		Crossing 2 Cross Slope (%)	**3.1**
N/A	Gutter Ponding	**N/A**	**N/A**	Curb Slope	**4.5**
Yes	Gutter Lip Height (in)	**0**		Road Run Slope (%)	**4.2**
N/A	Gutter Run Slope (%)	**N/A**		Road Cross Slope (%)	**2.3**
N/A	Gutter Cross Slope (%)	**N/A**	**No**	Perpendicular Joint Present	**No**
Yes	Overall Surface Condition	**Acceptable**			
	Cross Gutter Present?	**No**		Spandrel Present?	**No**
	Replace Cross Gutter?	**N/A**		Replace Spandrel?	**N/A**