




Access Compliance Report Public Rights-of-Way (Curb Ramps)



Main Street: NARROW_CANYON_RD **Cross Street:** N/A **Location:** SE

ADA ID: RPRK211028131519 **Ramp Type:** Type 4 - Parallel **Initial Pass/Fail:** Pass **Overall Compliance:** No **Severity Score:** 26

Codes/Mitigation Info/Possible Solution **Field Measurements/Component Compliance**

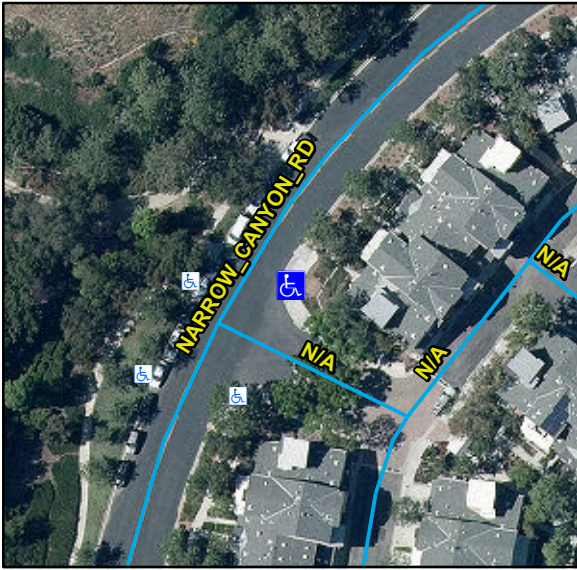

Possible Solutions:
Remove & Replace Curb Ramp With Two New Directional Ramps or Equivalent. Remove & Replace Gutter.

Surveyor Notes:
 N/A

OC Std/PROW:
R304.2.2, R204.3, R304.5.3, R304.2.1, R304.2.2-Perp, R304.3.2-Para, R305, R304.5.4, STD 1115

Total Cost: \$ 4252

Compliance	Description	Data	Compliance	Description	Data
N/A	Ramp Length LT (in)	139	N/A	Ramp Length RT (in)	146
Yes	Ramp Width LT (in)	90	Yes	Ramp Width RT (in)	90
Yes	Ramp Run Slope LT (%)	7.7	Yes	Ramp Run Slope RT (%)	3.2
Yes	Ramp Cross Slope LT (%)	1	No	Ramp Cross Slope RT (%)	2.5
N/A	Landing Present	No	No	DWS Provided	No
N/A	Landing Length (in)	N/A	N/A	DWS Contrast	N/A
No	Landing Width (in)	N/A	N/A	DWS Length (in)	N/A
No	Landing Run Slope (%)	N/A	N/A	DWS Full Width	N/A
No	Landing Cross Slope (%)	N/A		DWS Offset Type	N/A
N/A	Landing Movement Obstructed?	No	N/A	DWS Offset Left (in)	N/A
	Landing Movement Type	Curb	N/A	DWS Offset Right (in)	N/A
N/A	Landing Shared	N/A			
N/A	Clear Space	Yes			
N/A	Clear Space To Crosswalk (in)	48			
N/A	Marked Crosswalk 1	No	N/A	Marked Crosswalk 2	No
	Crossing 1 Direction	N		Crossing 2 Direction	SW
N/A	Marked Crosswalk 1 Width (in)	N/A	N/A	Marked Crosswalk 2 Width (in)	N/A
N/A	Ramp Inside Crosswalk 1	N/A	N/A	Ramp Inside Crosswalk 2	N/A
	Crossing 1 Slope (%)	3.8		Crossing 2 Slope (%)	2.9
	Crossing 1 Cross Slope (%)	2.6		Crossing 2 Cross Slope (%)	2.5
Yes	Gutter Ponding	No	No	Curb Slope	9.3
Yes	Gutter Lip Height (in)	0		Road Run Slope (%)	3.1
No	Gutter Run Slope (%)	11.2		Road Cross Slope (%)	0.3
Yes	Gutter Cross Slope (%)	2.2	No	Perpendicular Joint Present	No
Yes	Overall Surface Condition	Acceptable			
	Cross Gutter Present?	No		Spandrel Present?	No
	Replace Cross Gutter?	N/A		Replace Spandrel?	N/A

Parcel ID Number: 741-272-16
Ramp Island Or Median: None
Ramp Orientation: Diag
Google Street View Link:
http://www.google.com/maps/@?api=1&map_action=pano&viewpoint=33.54801402,-117.64811403

Street 1 Name: NARROW_CANYON_RD
Stop Condition-Street 1: NoControl
Street 2 Name: N/A
Stop Condition-Street 2: NoControl

Obstruction and Utility Measurement/Component Compliance

Compliance	Description	Data	Compliance	Description	Data
Yes	Obstructions Present?	No	N/A	Utilities Present?	No
	Obstruction Types	N/A		Utility Types	
	Obstruction Dimensions	N/A			N/A

