




Access Compliance Report Public Rights-of-Way (Curb Ramps)

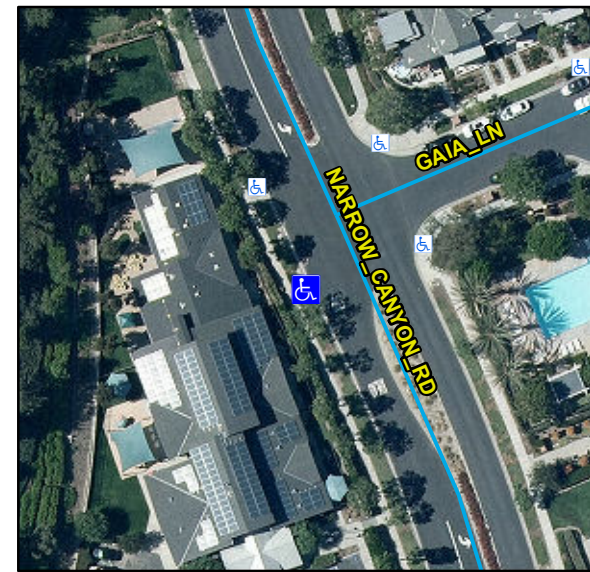

Main Street: NARROW_CANYON_RD		Cross Street: NARROW_CANYON_RD		Location:	S
ADA ID: RPRK211028132359	Ramp Type: No Ramp	Initial Pass/Fail: N/A	Overall Compliance: No	Severity Score:	100
Codes/Mitigation Info/Possible Solution			Field Measurements/Component Compliance		



Possible Solutions:

Provide Curb Ramp

Surveyor Notes:

N/A

OC Std/PROW:

STD 1115

Total Cost: \$ 3080

Parcel ID Number 741-275-45
Ramp Island Or Median N/A
Ramp Orientation N/A
Google Street View Link:

http://www.google.com/maps/@?api=1&map_action=pano&viewpoint=33.54635319,-117.6482241

Street 1 Name NARROW_CANYON_RD
Stop Condition-Street 1 N/A
Street 2 Name NARROW_CANYON_RD
Stop Condition-Street 2 N/A

Compliance	Description	Data	Compliance	Description	Data

