



Access Compliance Report Public Rights-of-Way (Curb Ramps)




Main Street: **NARROW_CANYON_RD** Cross Street: **NARROW_CANYON_RD** Location: **S**

ADA ID: **RPRK211103163132** Ramp Type: **Type 1 - Perpendicular** Initial Pass/Fail: **Pass** Overall Compliance: **No** Severity Score: **26**

Codes/Mitigation Info/Possible Solution

Field Measurements/Component Compliance

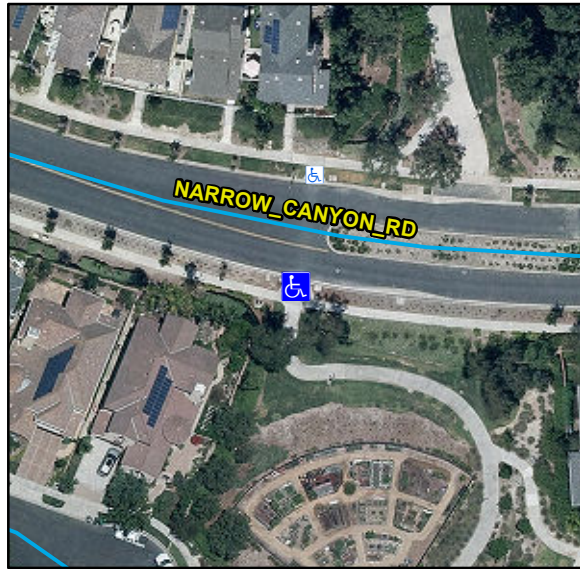

Possible Solutions:

Remove & Replace Entire Ramp. Remove & Replace Gutter.

Surveyor Notes:

N/A

OC Std/PROW:

R304.2.2, R305, R302.7.2, R304.5.4, STD 1115

Total Cost: \$ **3332**

Parcel ID Number **741-351-51**
Ramp Island Or Median **None**
Ramp Orientation **NonDiag**
Google Street View Link:

http://www.google.com/maps/@?api=1&map_action=pano&viewpoint=33.53755646,-117.64535001

Street 1 Name **NARROW_CANYON_RD**
Stop Condition-Street 1 **NoControl**
Street 2 Name **NARROW_CANYON_RD**
Stop Condition-Street 2 **N/A**

Obstruction and Utility Measurement/Component Compliance

Compliance	Description	Data	Compliance	Description	Data
Yes	Obstructions Present?	No	N/A	Utilities Present?	No
	Obstruction Types	N/A		Utility Types	
	Obstruction Dimensions	N/A			N/A

Compliance	Description	Data	Compliance	Description	Data
N/A	Ramp Length (in)	88	N/A	Flare Type LT	
Yes	Ramp Width (in)	72			Sloped
Yes	Ramp Run Slope (%)	5.1	N/A	Flare Slope LT (%)	11.3
Yes	Ramp Cross Slope (%)	1.6	N/A	Flare Traversable LT	No
N/A	Landing Present	Yes	N/A	Flare Type RT	
N/A	Landing Length (in)	60			Sloped
Yes	Landing Width (in)	72	N/A	Flare Slope RT (%)	10.8
Yes	Landing Run Slope (%)	1	N/A	Flare Traversable RT	No
Yes	Landing Cross Slope (%)	0.6	No	DWS Provided	No
N/A	Landing Movement Obstructed?	No	N/A	DWS Contrast	N/A
	Landing Movement Type	N/A	N/A	DWS Length (in)	N/A
N/A	Landing Shared	No	N/A	DWS Full Width	N/A
N/A	Clear Space	N/A	N/A	DWS Offset Left (in)	N/A
N/A	Clear Space To Crosswalk (in)	N/A	N/A	DWS Offset Right (in)	N/A
N/A	Marked Crosswalk 1	No	N/A	Marked Crosswalk 2	N/A
	Crossing 1 Direction	N		Crossing 2 Direction	N/A
	Marked Crosswalk 1 Width (in)	N/A		Marked Crosswalk 2 Width (in)	N/A
N/A	Ramp Inside Crosswalk 1	N/A	Yes	Ramp Inside Crosswalk 2	N/A
	Crossing 1 Slope (%)	2.4		Crossing 2 Slope (%)	N/A
	Crossing 1 Cross Slope (%)	0.1		Crossing 2 Cross Slope (%)	N/A
Yes	Gutter Ponding	No	No	Curb Slope	5.2
No	Gutter Lip Height (in)	1		Road Run Slope (%)	N/A
No	Gutter Run Slope (%)	12.8		Road Cross Slope (%)	N/A
Yes	Gutter Cross Slope (%)	0.8			
Yes	Overall Surface Condition: Acceptable		Yes	Perp Joint Present	Yes
	Cross Gutter Present?	No		Spandrel Present?	No
	Replace Cross Gutter?	N/A		Replace Spandrel?	N/A

