




Access Compliance Report Public Rights-of-Way (Curb Ramps)

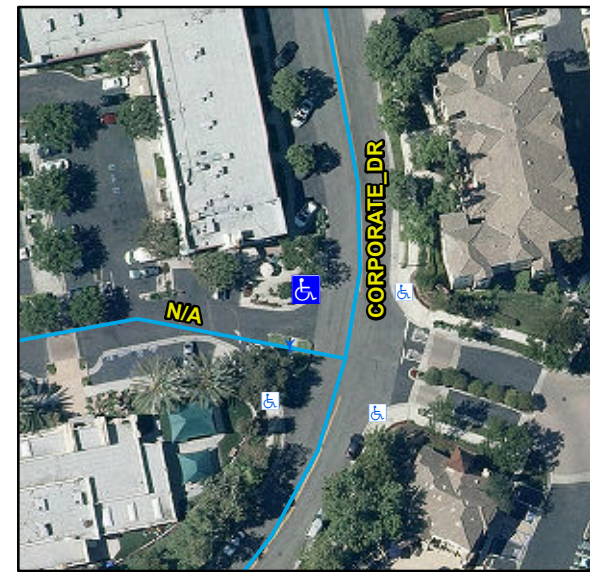

Main Street: CORPORATE_DR		Cross Street: CORPORATE_DR		Location:	NW
ADA ID: RPRK211116122612	Ramp Type: Type 4 - Parallel	Initial Pass/Fail: Pass	Overall Compliance: No	Severity Score:	25
Codes/Mitigation Info/Possible Solution			Field Measurements/Component Compliance		



Possible Solutions:

Remove & Replace Curb Ramp With Two New Directional Ramps or Equivalent. Remove & Replace Gutter.

Surveyor Notes:

N/A

OC Std/PROW:

R304.2.1, R304.2.2-Perp, R304.3.2-Para, R304.5.3, R305, R304.5.4, STD 1115

Total Cost: \$ 4252

Parcel ID Number **780-242-12**
Ramp Island Or Median **None**
Ramp Orientation **Diag**
Google Street View Link:

http://www.google.com/maps/@?api=1&map_action=pano&viewpoint=33.55456224,-117.62883572

Street 1 Name **CORPORATE_DR**
Stop Condition-Street 1 **NoControl**
Street 2 Name **CORPORATE_DR**
Stop Condition-Street 2 **NoControl**

Obstruction and Utility Measurement/Component Compliance

Compliance	Description	Data	Compliance	Description	Data
Yes	Obstructions Present?	No	N/A	Utilities Present?	No
	Obstruction Types	N/A		Utility Types	
	Obstruction Dimensions	N/A			N/A

Compliance	Description	Data	Compliance	Description	Data
N/A	Ramp Length LT (in)	62	N/A	Ramp Length RT (in)	100
Yes	Ramp Width LT (in)	95	Yes	Ramp Width RT (in)	95
Yes	Ramp Run Slope LT (%)	6.8	Yes	Ramp Run Slope RT (%)	7.8
Yes	Ramp Cross Slope LT (%)	1.7	Yes	Ramp Cross Slope RT (%)	1.1
N/A	Landing Present	No	No	DWS Provided	No
N/A	Landing Length (in)	N/A	N/A	DWS Contrast	N/A
No	Landing Width (in)	N/A	N/A	DWS Length (in)	N/A
No	Landing Run Slope (%)	N/A	N/A	DWS Full Width	N/A
No	Landing Cross Slope (%)	N/A		DWS Offset Type	N/A
N/A	Landing Movement Obstructed?	No	N/A	DWS Offset Left (in)	N/A
	Landing Movement Type	Curb	N/A	DWS Offset Right (in)	N/A
N/A	Landing Shared	N/A			
N/A	Clear Space	Yes			
N/A	Clear Space To Crosswalk (in)	48			
N/A	Marked Crosswalk 1	No	N/A	Marked Crosswalk 2	No
	Crossing 1 Direction	S		Crossing 2 Direction	E
N/A	Marked Crosswalk 1 Width (in)	N/A		Marked Crosswalk 2 Width (in)	N/A
N/A	Ramp Inside Crosswalk 1	N/A	N/A	Ramp Inside Crosswalk 2	N/A
	Crossing 1 Slope (%)	3.6		Crossing 2 Slope (%)	2.5
	Crossing 1 Cross Slope (%)	1.9		Crossing 2 Cross Slope (%)	1.2
Yes	Gutter Ponding	No	Yes	Curb Slope	4.3
Yes	Gutter Lip Height (in)	0		Road Run Slope (%)	2.7
No	Gutter Run Slope (%)	5.7		Road Cross Slope (%)	1.9
Yes	Gutter Cross Slope (%)	0.9	Yes	Perpendicular Joint Present	Yes
Yes	Overall Surface Condition	Acceptable			
	Cross Gutter Present?	No		Spandrel Present?	No
	Replace Cross Gutter?	N/A		Replace Spandrel?	N/A

