


## **Access Compliance Report Public Rights-of-Way** (Curb Ramps)



Main Street: ASCENSO AVE **Cross Street: SENDERO WAY** Location: ADA ID: RPRK211117153405 Ramp Type:Type 1 - Perpendicular Initial Pass/Fail: Fail **Overall Compliance: No Severity Score:** 15

Codes/Mitigation Info/Possible Solution

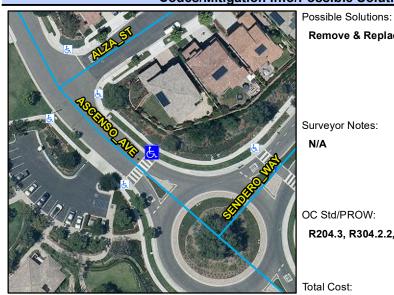

Remove & Replace Entire Ramp.

Surveyor Notes:

N/A

OC Std/PROW:

R204.3, R304.2.2, STD 1115

Total Cost:

3080

Parcel ID Number	741-581-79
Ramp Island Or Median	None
Ramp Orientation	NonDiag
Google Street View Link:	

Street 1 Name **ASCENSO AVE** Stop Condition-Street 1 YieldSign Street 2 Name SENDERO\_WAY Stop Condition-Street 2 N/A

http://www.google.com/maps/@?api=1&map\_action=pano&viewpoint=33.52689693,-117.62418648

## **Obstruction and Utility Measurement/Component Compliance**

Compliance Description	Data Compliance Description	<u>Data</u>
Yes Obstructions Present?	No N/A Utilities Present?	No
Obstruction Types	N/A Utility Types	
Obstruction Dimensions	N/A	N/A



Field Measurements/Component Compliance									
	Compliance Description		Data	Com	pliance	Description	Data		
	N/A	Ramp Length (in)	61	N/A	Flare Ty	pe LT			
	Yes	Ramp Width (in)	60				N/A		
	No	Ramp Run Slope (%)	8.7	N/A	Flare Slo	ppe LT (%)	N/A		
	Yes	Ramp Cross Slope (%)	0.9	N/A	Flare Tra	aversable LT	N/A		
	N/A	Landing Present	N/A	N/A	Flare Ty	pe RT			
	N/A	Landing Length (in)	N/A				N/A		
	N/A	Landing Width (in)	N/A	N/A	Flare Slo	ppe RT (%)	N/A		
	N/A	Landing Run Slope (%)	N/A	N/A	Flare Tra	aversable RT	N/A		
	N/A	Landing Cross Slope (%)	N/A	N/A	DWS Pr	ovided	N/A		
	N/A	Landing Movement Obstructed?	N/A	N/A	DWS Co	ontrast	N/A		
		Landing Movement Type	N/A	N/A	DWS Le	ngth (in)	N/A		
	N/A	Landing Shared	N/A	N/A	DWS Fu	ll Width	N/A		
	N/A	Clear Space	N/A	N/A	DWS Of	fset Left (in)	N/A		
	N/A	Clear Space To Crosswalk (in)	N/A	N/A	DWS Of	fset Right (in)	N/A		
0	N/A	Marked Crosswalk 1	Yes	N/A	Marked	Crosswalk 2	N/A		
		Crossing 1 Direction	SW		Crossing	g 2 Direction	N/A		
E		Marked Crosswalk 1 Width (in)	144		Marked	Crosswalk 2 Width (in)	N/A		
n	N/A	Ramp Inside Crosswalk 1	Yes	Yes	Ramp In	side Crosswalk 2	N/A		
Y		Crossing 1 Slope (%)	4.6		Crossing	g 2 Slope (%)	N/A		
Α		Crossing 1 Cross Slope (%)	2		Crossing	g 2 Cross Slope (%)	N/A		
	N/A	Gutter Ponding	N/A	N/A	Curb Slo	рре	1		
	Yes	Gutter Lip Height (in)	0		Road R	un Slope (%)	N/A		
	N/A	Gutter Run Slope (%)	N/A		Road Cr	oss Slope (%)	N/A		
<u>a</u>	N/A	Gutter Cross Slope (%)	N/A						
0	Yes	Overall Surface Condition: Accep	otable	No	Perp Jo	nt Present	No		
		Cross Gutter Present?	No		Spandre	I Present?	No		
A		Replace Cross Gutter?	N/A		Replace	Spandrel?	N/A		