




# Access Compliance Report Public Rights-of-Way (Curb Ramps)



Main Street: N/A Cross Street: CONTIGO\_PL Location: E

ADA ID: RPRK211122135621 Ramp Type: Type 6 - Directional 1 Initial Pass/Fail: Pass Overall Compliance: No Severity Score: 0

**Codes/Mitigation Info/Possible Solution** **Field Measurements/Component Compliance**

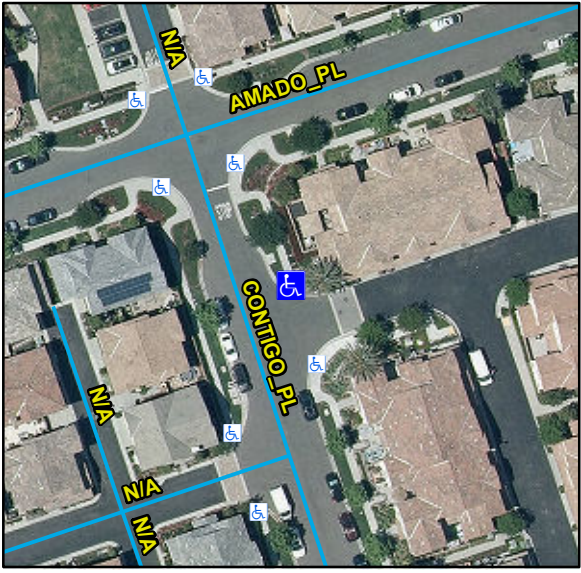

Possible Solutions:  
**Remove & Replace Entire Ramp.**

Surveyor Notes:  
N/A

OC Std/PROW:  
**R304.5.3, STD 1115**

Total Cost: \$ 3080

Parcel ID Number: **741-591-79**  
 Ramp Island Or Median: **None**  
 Ramp Orientation: **NonDiag**  
 Google Street View Link:  
[http://www.google.com/maps/@?api=1&map\\_action=pano&viewpoint=33.52557164,-117.62144093](http://www.google.com/maps/@?api=1&map_action=pano&viewpoint=33.52557164,-117.62144093)

Street 1 Name: N/A  
 Stop Condition-Street 1: **NoControl**  
 Street 2 Name: **CONTIGO\_PL**  
 Stop Condition-Street 2: N/A

**Obstruction and Utility Measurement/Component Compliance**

Compliance	Description	Data	Compliance	Description	Data
Yes	Obstructions Present?	No	N/A	Utilities Present?	No
	Obstruction Types	N/A		Utility Types	
	Obstruction Dimensions	N/A			N/A

Compliance	Description	Data	Compliance	Description	Data
N/A	Ramp Length (in)	108	N/A	Flare Type LT	
Yes	Ramp Width (in)	48			Sloped
Yes	Ramp Run Slope (%)	8.3	N/A	Flare Slope LT (%)	9.7
Yes	Ramp Cross Slope (%)	1.1	N/A	Flare Traversable LT	No
Yes	Grade Break	Yes	Yes	Flare Type RT	
Yes	Grade Break Slope (%)	2.2			Curbed2
No	Grade Break Cross Slope (%)	3	N/A	Flare Slope RT (%)	N/A
	Addl Para Ramp Left?	No	N/A	Flare Traversable RT	N/A
	Addl Para Ramp Right?	No	Yes	DWS Provided	Yes
N/A	Landing Present	Yes	Yes	DWS Contrast	Yes
Yes	Landing Length (in)	49	Yes	DWS Length (in)	72
Yes	Landing Width (in)	48	Yes	DWS Full Width	Yes
Yes	Landing Run Slope (%)	0.2		DWS Offset Type	Single
No	Landing Cross Slope (%)	3.8	Yes	DWS Left Offset (in)	0
N/A	Landing Movement Obstructed?	No	N/A	DWS Right Offset (in)	0
	Landing Movement Type	N/A			
N/A	Landing Shared	No			
N/A	Marked Crosswalk 1	No	N/A	Clear Space	N/A
	Crossing 1 Direction	S	N/A	Clear Space To Crosswalk (in)	N/A
	Marked Crosswalk 1 Width (in)	N/A			
N/A	Ramp Inside Crosswalk 1	N/A			
	Crossing 1 Slope (%)	1.4			
	Crossing 1 Cross Slope (%)	2.9			
Yes	Gutter Ponding	No	Yes	Curb Slope	1.9
Yes	Gutter Lip Height (in)	0		Road Run Slope (%)	N/A
Yes	Gutter Run Slope (%)	4.5		Road Cross Slope (%)	N/A
Yes	Gutter Cross Slope (%)	1.3		Parallel Ramp Side	Right
Yes	Overall Surface Condition	Acceptable	Yes	Perp Joint Present	Yes
	Cross Gutter Present?	No		Spandrel Present?	No
	Replace Cross Gutter?	N/A		Replace Spandrel?	N/A

