



Access Compliance Report Public Rights-of-Way (Curb Ramps)




Main Street: MEDANO_ST Cross Street: TOPAZ_ST Location: SW

ADA ID: RPRK211130130919 Ramp Type: Type 1 - Perpendicular Diagonal Initial Pass/Fail: Pass Overall Compliance: No Severity Score: 6

Codes/Mitigation Info/Possible Solution

Field Measurements/Component Compliance

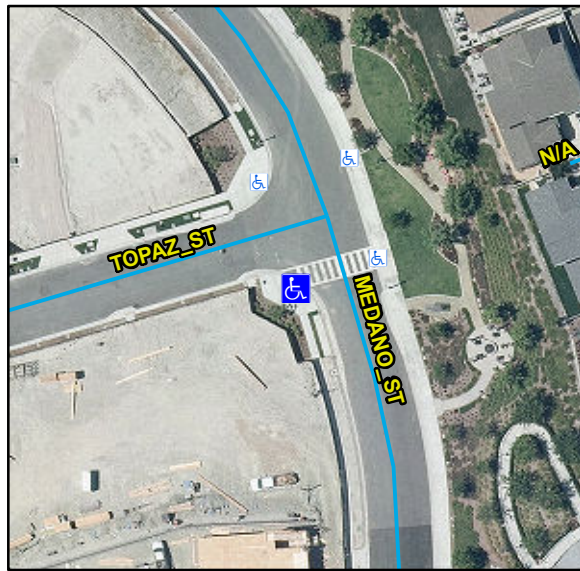

Possible Solutions:

Remove & Replace Landing. Remove & Replace Gutter.

Surveyor Notes:

N/A

OC Std/PROW:

R304.2.2-Perp, R304.3.2-Para, R304.5.4, R304.5.3, STD 1115

Total Cost: \$ 783

Parcel ID Number

Ramp Island Or Median

None

Ramp Orientation

Diag

Google Street View Link:

http://www.google.com/maps/@?api=1&map_action=pano&viewpoint=33.55215372,-117.60119479

Street 1 Name

MEDANO_ST

Stop Condition-Street 1

YieldSign

Street 2 Name

TOPAZ_ST

Stop Condition-Street 2

StopSign

Obstruction and Utility Measurement/Component Compliance

Compliance	Description	Data	Compliance	Description	Data
Yes	Obstructions Present?	No	N/A	Utilities Present?	No
	Obstruction Types	N/A		Utility Types	
	Obstruction Dimensions	N/A			N/A

Compliance	Description	Data	Compliance	Description	Data
N/A	Ramp Length (in)	116	N/A	Flare Type LT	
Yes	Ramp Width (in)	48			Sloped
Yes	Ramp Run Slope (%)	7.6	Yes	Flare Slope LT (%)	9.5
Yes	Ramp Cross Slope (%)	1	N/A	Flare Traversable LT	Yes
N/A	Landing Present	Yes	N/A	Flare Type RT	
N/A	Landing Length (in)	55			Sloped
Yes	Landing Width (in)	48	Yes	Flare Slope RT (%)	5.8
No	Landing Run Slope (%)	3.4	N/A	Flare Traversable RT	Yes
Yes	Landing Cross Slope (%)	0.2	Yes	DWS Provided	Yes
N/A	Landing Movement Obstructed?	No	Yes	DWS Contrast	Yes
	Landing Movement Type	N/A	Yes	DWS Length (in)	36
N/A	Landing Shared	No	Yes	DWS Full Width	Yes
N/A	Clear Space	Yes	Yes	DWS Offset Left (in)	0
N/A	Clear Space To Crosswalk (in)	48	Yes	DWS Offset Right (in)	N/A
N/A	Marked Crosswalk 1	Yes	N/A	Marked Crosswalk 2	No
	Crossing 1 Direction	E		Crossing 2 Direction	N
	Marked Crosswalk 1 Width (in)	144		Marked Crosswalk 2 Width (in)	N/A
Yes	Ramp Inside Crosswalk 1	Yes	Yes	Ramp Inside Crosswalk 2	N/A
	Crossing 1 Slope (%)	7.3		Crossing 2 Slope (%)	5.3
	Crossing 1 Cross Slope (%)	2		Crossing 2 Cross Slope (%)	0.8
Yes	Gutter Ponding	No	Yes	Curb Slope	0.6
Yes	Gutter Lip Height (in)	0		Road Run Slope (%)	2.3
No	Gutter Run Slope (%)	7.7		Road Cross Slope (%)	3.8
No	Gutter Cross Slope (%)	3.4			
Yes	Overall Surface Condition: Acceptable		Yes	Perp Joint Present	Yes
	Cross Gutter Present?	No		Spandrel Present?	No
	Replace Cross Gutter?	N/A		Replace Spandrel?	N/A

