




# Access Compliance Report Public Rights-of-Way (Curb Ramps)

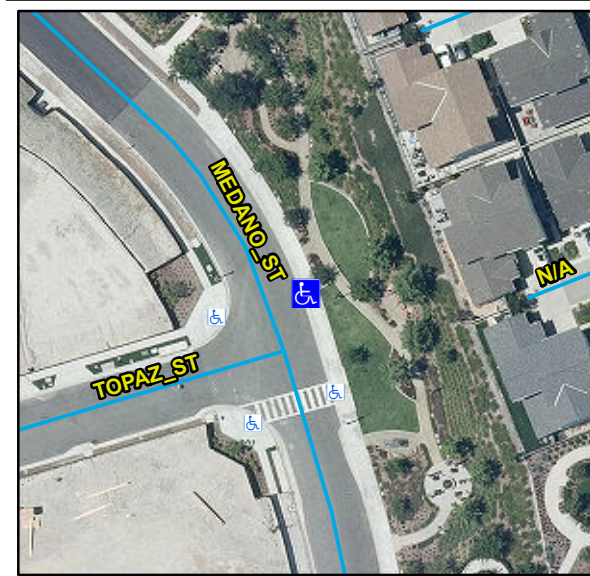

|                                         |                    |                        |                                         |                 |     |
|-----------------------------------------|--------------------|------------------------|-----------------------------------------|-----------------|-----|
| Main Street: MEDANO_ST                  |                    | Cross Street: TOPAZ_ST |                                         | Location:       | N   |
| ADA ID: RPRK211130131547                | Ramp Type: No Ramp | Initial Pass/Fail: N/A | Overall Compliance: No                  | Severity Score: | 100 |
| Codes/Mitigation Info/Possible Solution |                    |                        | Field Measurements/Component Compliance |                 |     |



Possible Solutions:

Provide Curb Ramp

Surveyor Notes:

N/A

OC Std/PROW:

STD 1115

Total Cost: \$ 3080

|                          |            |                         |           |
|--------------------------|------------|-------------------------|-----------|
| Parcel ID Number         | 125-311-65 | Street 1 Name           | MEDANO_ST |
| Ramp Island Or Median    | N/A        | Stop Condition-Street 1 | N/A       |
| Ramp Orientation         | N/A        | Street 2 Name           | TOPAZ_ST  |
| Google Street View Link: |            | Stop Condition-Street 2 | N/A       |

[http://www.google.com/maps/@?api=1&map\\_action=pano&viewpoint=33.55234088,-117.60110722](http://www.google.com/maps/@?api=1&map_action=pano&viewpoint=33.55234088,-117.60110722)

| Compliance | Description | Data | Compliance | Description | Data |
|------------|-------------|------|------------|-------------|------|
|            |             |      |            |             |      |

