



Access Compliance Report Public Rights-of-Way (Curb Ramps)




Main Street: N/A Cross Street: ORTEGA_HWY Location: E

ADA ID: RPRK211202131522 Ramp Type: Type 1 - Perpendicular Initial Pass/Fail: Pass Overall Compliance: No Severity Score: 22

Codes/Mitigation Info/Possible Solution

Field Measurements/Component Compliance

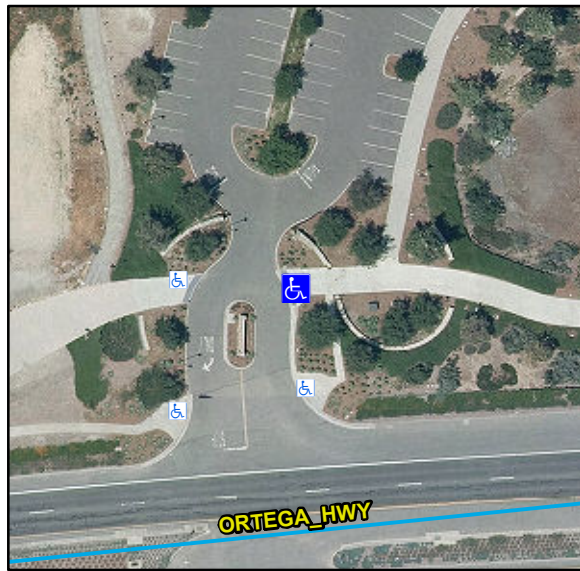

Possible Solutions:

Relocate Obstruction. Utility Present.

Surveyor Notes:

N/A

OC Std/PROW:

R302.3, R402.2, STD 1115

Total Cost: \$ 5000

Parcel ID Number 741-641-12
Ramp Island Or Median None
Ramp Orientation NonDiag
Google Street View Link:

http://www.google.com/maps/@?api=1&map_action=pano&viewpoint=33.51969288,-117.62338418

Street 1 Name N/A
Stop Condition-Street 1 NoControl
Street 2 Name ORTEGA_HWY
Stop Condition-Street 2 N/A

Obstruction and Utility Measurement/Component Compliance

Compliance	Description	Data	Compliance	Description	Data
No	Obstructions Present?	Yes	N/A	Utilities Present?	Yes
	Obstruction Types	Storm Grate		Utility Types	
	Obstruction Dimensions	N/A		Pull Box	

Compliance	Description	Data	Compliance	Description	Data
N/A	Ramp Length (in)	108	Yes	Flare Type LT	Curbed2
Yes	Ramp Width (in)	244			
Yes	Ramp Run Slope (%)	4.1	N/A	Flare Slope LT (%)	N/A
Yes	Ramp Cross Slope (%)	0.3	N/A	Flare Traversable LT	N/A
N/A	Landing Present	Yes	N/A	Flare Type RT	
N/A	Landing Length (in)	121			Sloped
Yes	Landing Width (in)	80	Yes	Flare Slope RT (%)	0.5
Yes	Landing Run Slope (%)	1.8	N/A	Flare Traversable RT	Yes
Yes	Landing Cross Slope (%)	1	Yes	DWS Provided	Yes
N/A	Landing Movement Obstructed?	No	Yes	DWS Contrast	Yes
	Landing Movement Type	N/A	Yes	DWS Length (in)	36
N/A	Landing Shared	No	Yes	DWS Full Width	Yes
N/A	Clear Space	N/A	Yes	DWS Offset Left (in)	0
N/A	Clear Space To Crosswalk (in)	N/A	Yes	DWS Offset Right (in)	N/A
N/A	Marked Crosswalk 1	No	N/A	Marked Crosswalk 2	N/A
	Crossing 1 Direction	W		Crossing 2 Direction	N/A
	Marked Crosswalk 1 Width (in)	N/A		Marked Crosswalk 2 Width (in)	N/A
N/A	Ramp Inside Crosswalk 1	N/A	No	Ramp Inside Crosswalk 2	N/A
	Crossing 1 Slope (%)	1.9		Crossing 2 Slope (%)	N/A
	Crossing 1 Cross Slope (%)	0.1		Crossing 2 Cross Slope (%)	N/A
Yes	Gutter Ponding	No	Yes	Curb Slope	0.9
Yes	Gutter Lip Height (in)	0		Road Run Slope (%)	N/A
Yes	Gutter Run Slope (%)	1.7		Road Cross Slope (%)	N/A
Yes	Gutter Cross Slope (%)	0.5			
Yes	Overall Surface Condition: Acceptable		Yes	Perp Joint Present	Yes
	Cross Gutter Present?	No		Spandrel Present?	No
	Replace Cross Gutter?	N/A		Replace Spandrel?	N/A

