



Access Compliance Report Public Rights-of-Way (Curb Ramps)




Main Street: N/A Cross Street: ROSSMOOR_CENTER_WAY Location: S

ADA ID: RPRK211208115544 Ramp Type: Type 1 - Perpendicular Initial Pass/Fail: Pass Overall Compliance: No Severity Score: 5

Codes/Mitigation Info/Possible Solution

Field Measurements/Component Compliance

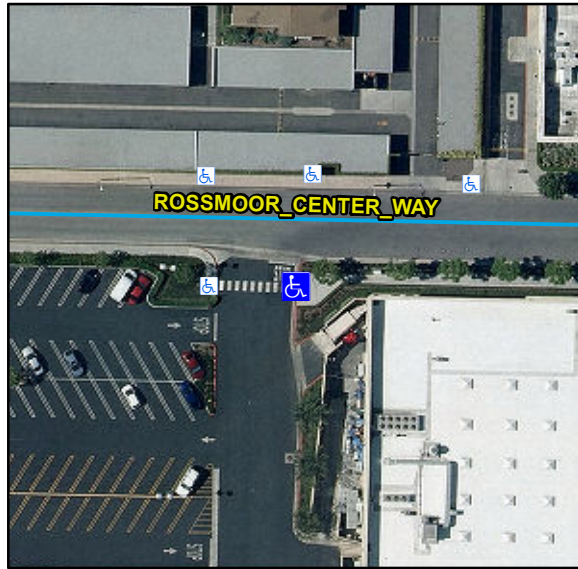

Possible Solutions:

Remove & Replace Curb Slope. Remove & Replace Gutter.

Surveyor Notes:

N/A

OC Std/PROW:

R304.2.2, R304.5.4, R304.5.3, STD 1115

Total Cost: \$ 504

Parcel ID Number 086-492-90
Ramp Island Or Median None
Ramp Orientation NonDiag
Google Street View Link:

http://www.google.com/maps/@?api=1&map_action=pano&viewpoint=33.78436248,-118.07387962

Street 1 Name N/A
Stop Condition-Street 1 StopSign
Street 2 Name ROSSMOOR_CENTER_WAY
Stop Condition-Street 2 N/A

Obstruction and Utility Measurement/Component Compliance

Compliance	Description	Data	Compliance	Description	Data
Yes	Obstructions Present?	No	N/A	Utilities Present?	No
	Obstruction Types	N/A		Utility Types	
	Obstruction Dimensions	N/A			N/A

Compliance	Description	Data	Compliance	Description	Data
N/A	Ramp Length (in)	67	N/A	Flare Type LT	
Yes	Ramp Width (in)	60			Sloped
Yes	Ramp Run Slope (%)	7.6	N/A	Flare Slope LT (%)	2.8
Yes	Ramp Cross Slope (%)	0.2	N/A	Flare Traversable LT	No
N/A	Landing Present	Yes	N/A	Flare Type RT	
N/A	Landing Length (in)	56			Sloped
Yes	Landing Width (in)	60	N/A	Flare Slope RT (%)	11
Yes	Landing Run Slope (%)	1.7	N/A	Flare Traversable RT	No
Yes	Landing Cross Slope (%)	0.2	Yes	DWS Provided	Yes
N/A	Landing Movement Obstructed?	No	Yes	DWS Contrast	Yes
	Landing Movement Type	N/A	Yes	DWS Length (in)	36
N/A	Landing Shared	Yes	Yes	DWS Full Width	Yes
N/A	Clear Space	N/A	Yes	DWS Offset Left (in)	0
N/A	Clear Space To Crosswalk (in)	N/A	Yes	DWS Offset Right (in)	N/A
N/A	Marked Crosswalk 1	Yes	N/A	Marked Crosswalk 2	N/A
	Crossing 1 Direction	W		Crossing 2 Direction	N/A
	Marked Crosswalk 1 Width (in)	60		Marked Crosswalk 2 Width (in)	N/A
Yes	Ramp Inside Crosswalk 1	Yes	Yes	Ramp Inside Crosswalk 2	N/A
	Crossing 1 Slope (%)	3.3		Crossing 2 Slope (%)	N/A
	Crossing 1 Cross Slope (%)	3.1		Crossing 2 Cross Slope (%)	N/A
Yes	Gutter Ponding	No	No	Curb Slope	7.8
Yes	Gutter Lip Height (in)	0		Road Run Slope (%)	N/A
No	Gutter Run Slope (%)	7.1		Road Cross Slope (%)	N/A
No	Gutter Cross Slope (%)	3.9			
Yes	Overall Surface Condition: Acceptable		Yes	Perp Joint Present	Yes
	Cross Gutter Present?	No		Spandrel Present?	No
	Replace Cross Gutter?	N/A		Replace Spandrel?	N/A

