


Access Compliance Report Public Rights-of-Way (Curb Ramps)

Main Street: **ORANGEWOOD_AVE** Cross Street: **ORANGEWOOD_AVE** Location: **N**

ADA ID: **RPRK211215143014** Ramp Type: **No Ramp** Initial Pass/Fail: **N/A** Overall Compliance: **No** Severity Score: **100**

Codes/Mitigation Info/Possible Solution

Field Measurements/Component Compliance

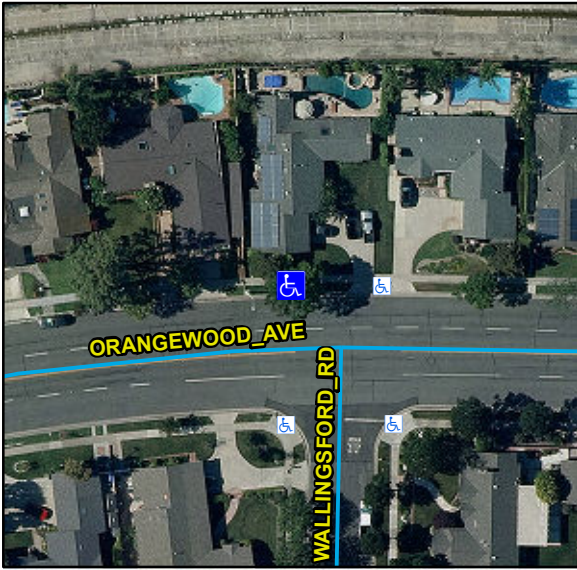

Possible Solutions:

Provide Curb Ramp

Surveyor Notes:

N/A

OC Std/PROW:

STD 1115

Total Cost: \$ **3080**

Compliance	Description	Data	Compliance	Description	Data

Parcel ID Number	086-052-15	Street 1 Name	ORANGEWOOD_AVE
Ramp Island Or Median	N/A	Stop Condition-Street 1	N/A
Ramp Orientation	N/A	Street 2 Name	ORANGEWOOD_AVE
Google Street View Link:		Stop Condition-Street 2	N/A

http://www.google.com/maps/@?api=1&map_action=pano&viewpoint=33.79595495,-118.07443685

