



Access Compliance Report Public Rights-of-Way (Curb Ramps)




Main Street: WEMBLEY_RD Cross Street: GERTRUDE_DR Location: NE

ADA ID: RPRK211216115037 Ramp Type: Type 1 - Perpendicular Diagonal Initial Pass/Fail: Pass Overall Compliance: No Severity Score: 16

Codes/Mitigation Info/Possible Solution

Field Measurements/Component Compliance

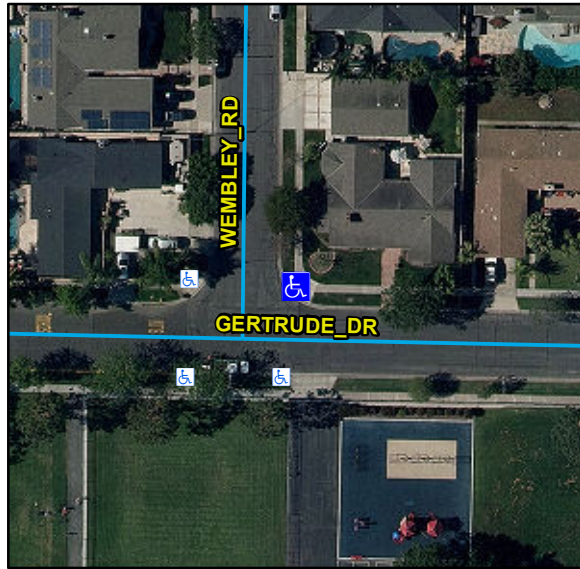

Possible Solutions:

Remove & Replace Curb Ramp With Two New Directional Ramps or Equivalent.

Surveyor Notes:

N/A

OC Std/PROW:

R304.2.2, R204.3, R304.2.1, R305, STD 1115

Total Cost: \$ 6160

Parcel ID Number **086-432-09**
Ramp Island Or Median **None**
Ramp Orientation **Diag**
Google Street View Link:

http://www.google.com/maps/@?api=1&map_action=pano&viewpoint=33.78163177,-118.08706658

Street 1 Name **WEMBLEY_RD**
Stop Condition-Street 1 **NoControl**
Street 2 Name **GERTRUDE_DR**
Stop Condition-Street 2 **NoControl**

Obstruction and Utility Measurement/Component Compliance

Compliance	Description	Data	Compliance	Description	Data
Yes	Obstructions Present?	No	N/A	Utilities Present?	No
	Obstruction Types	N/A		Utility Types	
	Obstruction Dimensions	N/A			N/A

Compliance	Description	Data	Compliance	Description	Data
N/A	Ramp Length (in)	87	N/A	Flare Type LT	
Yes	Ramp Width (in)	48			Sloped
Yes	Ramp Run Slope (%)	8.1	N/A	Flare Slope LT (%)	5
Yes	Ramp Cross Slope (%)	1.1	N/A	Flare Traversable LT	No
N/A	Landing Present	Yes	N/A	Flare Type RT	
N/A	Landing Length (in)	47			Sloped
Yes	Landing Width (in)	48	N/A	Flare Slope RT (%)	5.4
Yes	Landing Run Slope (%)	0	N/A	Flare Traversable RT	No
Yes	Landing Cross Slope (%)	1.2	No	DWS Provided	No
N/A	Landing Movement Obstructed?	No	N/A	DWS Contrast	N/A
	Landing Movement Type	N/A	N/A	DWS Length (in)	N/A
N/A	Landing Shared	No	N/A	DWS Full Width	N/A
N/A	Clear Space	Yes	N/A	DWS Offset Left (in)	N/A
N/A	Clear Space To Crosswalk (in)	48	N/A	DWS Offset Right (in)	N/A
N/A	Marked Crosswalk 1	No	N/A	Marked Crosswalk 2	No
	Crossing 1 Direction	W		Crossing 2 Direction	S
	Marked Crosswalk 1 Width (in)	N/A		Marked Crosswalk 2 Width (in)	N/A
N/A	Ramp Inside Crosswalk 1	N/A	Yes	Ramp Inside Crosswalk 2	N/A
	Crossing 1 Slope (%)	6.2		Crossing 2 Slope (%)	5.2
	Crossing 1 Cross Slope (%)	2.1		Crossing 2 Cross Slope (%)	0.6
Yes	Gutter Ponding	No	No	Curb Slope	6.7
Yes	Gutter Lip Height (in)	0		Road Run Slope (%)	0.6
Yes	Gutter Run Slope (%)	4.2		Road Cross Slope (%)	8.8
Yes	Gutter Cross Slope (%)	0.2			
Yes	Overall Surface Condition: Acceptable		No	Perp Joint Present	No
	Cross Gutter Present?	No		Spandrel Present?	No
	Replace Cross Gutter?	N/A		Replace Spandrel?	N/A

