




Access Compliance Report Public Rights-of-Way (Curb Ramps)



Main Street: KENSINGTON_RD		Cross Street: GERTRUDE_DR		Location:	NE
ADA ID: RPRK211220141635	Ramp Type: Type 1 - Perpendicular Diagonal Initial Pass/Fail: Pass		Overall Compliance: No	Severity Score:	10

Codes/Mitigation Info/Possible Solution			Field Measurements/Component Compliance		
---	--	--	---	--	--

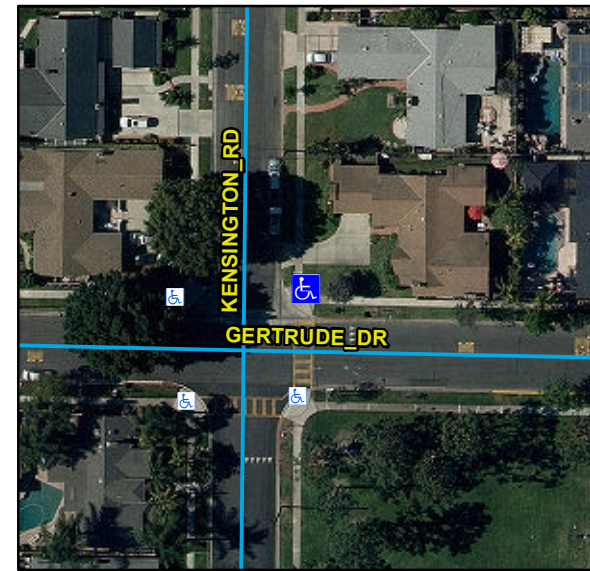

Possible Solutions:

Remove & Replace Curb Ramp With Two New Directional Ramps or Equivalent.

Surveyor Notes:

N/A

OC Std/PROW:

R204.3, R304.2.2-Perp, R304.3.2-Para, R305, STD 1115


Total Cost: \$ 6160

Parcel ID Number	086-433-05	Street 1 Name	KENSINGTON_RD
Ramp Island Or Median	None	Stop Condition-Street 1	YieldSign
Ramp Orientation	Diag	Street 2 Name	GERTRUDE_DR
Google Street View Link:		Stop Condition-Street 2	YieldSign

http://www.google.com/maps/@?api=1&map_action=pano&viewpoint=33.78164833,-118.08797285

Obstruction and Utility Measurement/Component Compliance

Compliance	Description	Data	Compliance	Description	Data
Yes	Obstructions Present?	No	N/A	Utilities Present?	No
	Obstruction Types	N/A		Utility Types	
	Obstruction Dimensions	N/A			N/A

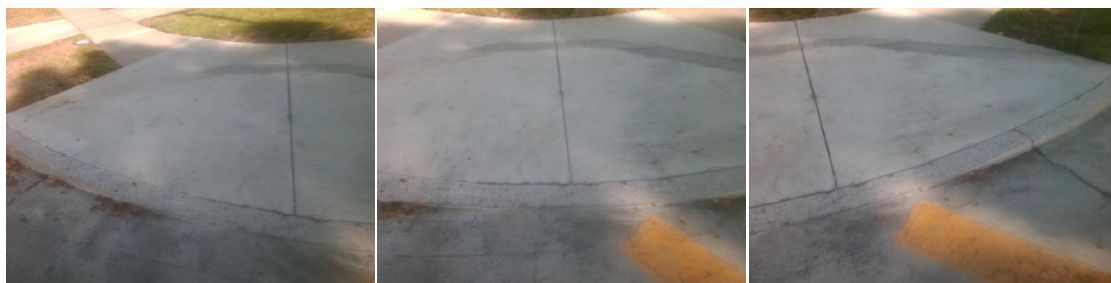

Compliance	Description	Data	Compliance	Description	Data
N/A	Ramp Length (in)	83	N/A	Flare Type LT	
Yes	Ramp Width (in)	48			Sloped
Yes	Ramp Run Slope (%)	8	N/A	Flare Slope LT (%)	5.5
Yes	Ramp Cross Slope (%)	0.5	N/A	Flare Traversable LT	No
N/A	Landing Present	Yes	N/A	Flare Type RT	
N/A	Landing Length (in)	48			Sloped
Yes	Landing Width (in)	48	N/A	Flare Slope RT (%)	5
No	Landing Run Slope (%)	2.6	N/A	Flare Traversable RT	No
Yes	Landing Cross Slope (%)	1.2	No	DWS Provided	No
N/A	Landing Movement Obstructed?	No	N/A	DWS Contrast	N/A
	Landing Movement Type	N/A	N/A	DWS Length (in)	N/A
N/A	Landing Shared	No	N/A	DWS Full Width	N/A
N/A	Clear Space	Yes	N/A	DWS Offset Left (in)	N/A
N/A	Clear Space To Crosswalk (in)	48	N/A	DWS Offset Right (in)	N/A
N/A	Marked Crosswalk 1	No	N/A	Marked Crosswalk 2	Yes
	Crossing 1 Direction	W		Crossing 2 Direction	S
	Marked Crosswalk 1 Width (in)	N/A		Marked Crosswalk 2 Width (in)	144
N/A	Ramp Inside Crosswalk 1	N/A	Yes	Ramp Inside Crosswalk 2	Yes
	Crossing 1 Slope (%)	2.8		Crossing 2 Slope (%)	4.7
	Crossing 1 Cross Slope (%)	1.7		Crossing 2 Cross Slope (%)	0.7
Yes	Gutter Ponding	No	Yes	Curb Slope	2.3
Yes	Gutter Lip Height (in)	0		Road Run Slope (%)	0.3
Yes	Gutter Run Slope (%)	0.2		Road Cross Slope (%)	0.1
Yes	Gutter Cross Slope (%)	0			
Yes	Overall Surface Condition: Acceptable		No	Perp Joint Present	No
	Cross Gutter Present?	Yes		Spandrel Present?	Yes
	Replace Cross Gutter?	No		Replace Spandrel?	No