


## Access Compliance Report Public Rights-of-Way (Curb Ramps)



Main Street: LOS\_ALAMITOS\_BLVD Cross Street: ORANGEWOOD\_AVE Location: SW

ADA ID: RPRK211221114131 Ramp Type: Type 4 - Parallel Initial Pass/Fail: Fail Overall Compliance: No Severity Score: 2

## Codes/Mitigation Info/Possible Solution

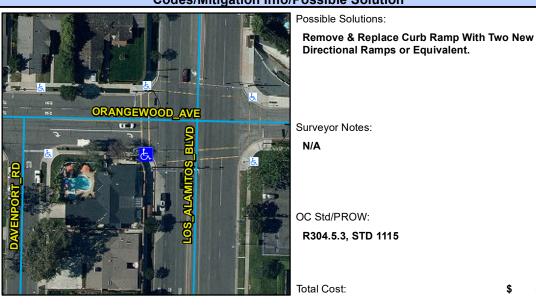

		•	
Parcel ID Number	086-082-01	Street 1 Name	LOS_ALAMITOS_BLVD
Ramp Island Or Median	None	Stop Condition-Street 1	Signal
Ramp Orientation	Diag	Street 2 Name	ORANGEWOOD_AVE
Google Street View Link:		Stop Condition-Street 2	Signal

http://www.google.com/maps/@?api=1&map\_action=pano&viewpoint=33.79575713,-118.07210456

## **Obstruction and Utility Measurement/Component Compliance**

Com	pliance Description	Data	Com	pliance Description D	ata
Yes	Obstructions Present?	No	N/A	Utilities Present?	No
	Obstruction Types	N/A		Utility Types	
	Obstruction Dimensions	N/A		1	N/A



Field Measurements/Component Compliance									
	Compliance Description		Data	Data Compliance Description					
N	N/A	Ramp Length LT (in)	94	N/A	Ramp Length RT (in)	83			
	Yes	Ramp Width LT (in)	123	Yes	Ramp Width RT (in)	123			
	Yes	Ramp Run Slope LT (%)	5.6	Yes	Ramp Run Slope RT (%)	6.9			
	No	Ramp Cross Slope LT (%)	3.6	No	Ramp Cross Slope RT (%)	3.9			
	N/A	Landing Present	N/A	N/A	DWS Provided	N/A			
	N/A	Landing Length (in)	N/A	N/A	DWS Contrast	N/A			
	N/A	Landing Width (in)	N/A	N/A	DWS Length (in)	N/A			
	N/A	Landing Run Slope (%)	N/A	N/A	DWS Full Width	N/A			
	N/A	Landing Cross Slope (%)	N/A		DWS Offset Type	N/A			
	N/A	Landing Movement Obstructed?	N/A	N/A	DWS Offset Left (in)	N/A			
		Landing Movement Type	N/A	N/A	DWS Offset Right (in)	N/A			
	N/A	Landing Shared	N/A						
	N/A	Clear Space	Yes						
	N/A	Clear Space To Crosswalk (in)	48						
4000	N/A	Marked Crosswalk 1	Yes	N/A	Marked Crosswalk 2	Yes			
		Crossing 1 Direction	Е		Crossing 2 Direction	N			
BLVD		Marked Crosswalk 1 Width (in)	144		Marked Crosswalk 2 Width (in)	144			
Signal	N/A	Ramp Inside Crosswalk 1	Yes	N/A	Ramp Inside Crosswalk 2	Yes			
D_AVE		Crossing 1 Slope (%)	6.6		Crossing 2 Slope (%)	5.8			
Signal		Crossing 1 Cross Slope (%)	0.2		Crossing 2 Cross Slope (%)	0.2			
	N/A	Gutter Ponding	N/A	N/A	Curb Slope	0.1			
	Yes	Gutter Lip Height (in)	0		Road Run Slope (%)	0.4			
	N/A	Gutter Run Slope (%)	N/A		Road Cross Slope (%)	3.5			
Data	N/A	Gutter Cross Slope (%)	N/A	Yes	Perpendicular Joint Present	Yes			
No	Yes	Overall Surface Condition Acceptable							
NIZA		Cross Gutter Present?	No		Spandrel Present?	No			
N/A		Replace Cross Gutter?	N/A		Replace Spandrel?	N/A			