Access Compliance Report
Public Rights-of-Way
(Curb Ramps)

Main Street: ERVIN_LN | **Cross Street: GIMBERT_LN** | **Location: NW**

ADA ID: RPRK220127132406 | **Ramp Type:Type 1 - Perpendicular Diagonal** | **Initial Pass/Fail: Pass** | **Overall Compliance: No** | **Severity Score: 0**

Codes/Mitigation Info/Possible Solution

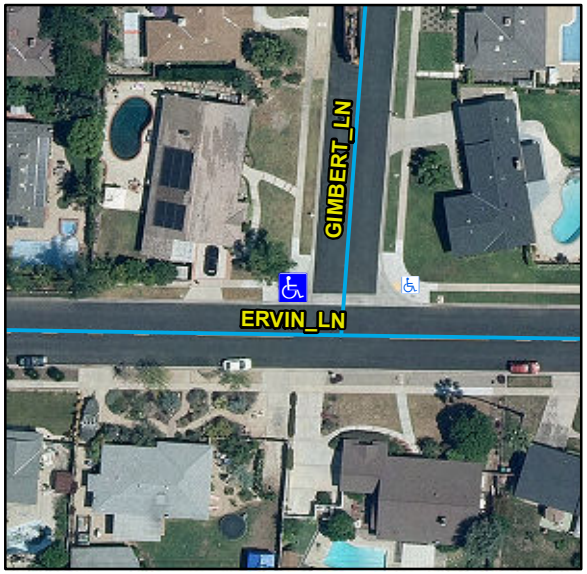

Possible Solutions:

Remove & Replace Curb Ramp With Two New Directional Ramps or Equivalent. Remove & Replace Gutter.

Surveyor Notes:

N/A

OC Std/PROW:

R304.2.2, R304.2.1, R304.2.2-Perp, R304.3.2-Para, R304.5.3, STD 1115

Total Cost: **$ 6412**

Parcel ID Number	395-553-06	Street 1 Name	ERVIN_LN
Ramp Island Or Median	None	Stop Condition-Street 1	NoControl
Ramp Orientation	Diag	Street 2 Name	GIMBERT_LN
Google Street View Link:		Stop Condition-Street 2	NoControl

http://www.google.com/maps/@?api=1&map_action=pano&viewpoint=33.76315398,-117.80352255

Obstruction and Utility Measurement/Component Compliance

Compliance	Description	Data	Compliance	Description	Data
Yes	Obstructions Present?	No	N/A	Utilities Present?	No
	Obstruction Types	N/A		Utility Types	
	Obstruction Dimensions	N/A			N/A

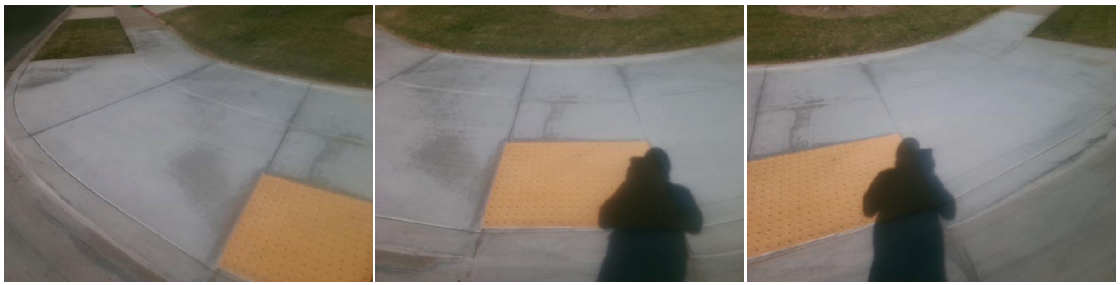

Field Measurements/Component Compliance

Compliance	Description	Data	Compliance	Description	Data
N/A	Ramp Length (in)	70	N/A	Flare Type LT	
Yes	Ramp Width (in)	48			Sloped
Yes	Ramp Run Slope (%)	7	N/A	Flare Slope LT (%)	5.8
Yes	Ramp Cross Slope (%)	0.6	N/A	Flare Traversable LT	No
N/A	Landing Present	Yes	N/A	Flare Type RT	
N/A	Landing Length (in)	49			Sloped
Yes	Landing Width (in)	48	N/A	Flare Slope RT (%)	8.5
No	Landing Run Slope (%)	2.4	N/A	Flare Traversable RT	No
Yes	Landing Cross Slope (%)	0.7	Yes	DWS Provided	Yes
N/A	Landing Movement Obstructed?	Yes	Yes	DWS Contrast	Yes
	Landing Movement Type	Curb	Yes	DWS Length (in)	36
N/A	Landing Shared	No	Yes	DWS Full Width	Yes
N/A	Clear Space	Yes	Yes	DWS Offset Left (in)	0
N/A	Clear Space To Crosswalk (in)	48	Yes	DWS Offset Right (in)	N/A
N/A	Marked Crosswalk 1	No	N/A	Marked Crosswalk 2	No
	Crossing 1 Direction	S		Crossing 2 Direction	E
	Marked Crosswalk 1 Width (in)	N/A		Marked Crosswalk 2 Width (in)	N/A
N/A	Ramp Inside Crosswalk 1	N/A	Yes	Ramp Inside Crosswalk 2	N/A
	Crossing 1 Slope (%)	4.5		Crossing 2 Slope (%)	2.7
	Crossing 1 Cross Slope (%)	0.2		Crossing 2 Cross Slope (%)	1.5
Yes	Gutter Ponding	No	No	Curb Slope	9.5
Yes	Gutter Lip Height (in)	0		Road Run Slope (%)	1.8
Yes	Gutter Run Slope (%)	0.9		Road Cross Slope (%)	2.3
No	Gutter Cross Slope (%)	2.4			
Yes	Overall Surface Condition: Acceptable		Yes	Perp Joint Present	Yes
	Cross Gutter Present?	Yes		Spandrel Present?	Yes
	Replace Cross Gutter?	No		Replace Spandrel?	No